

1 LOCATION OF WATER WELL:

County: ButlerFraction: NW 1/4 SE 1/4 NW 1/4Section Number: 15Township Number: T 27 SRange Number: R 4 E

Distance and direction from nearest town or city street address of well if located within city?

IN City Limits - Augusta

2 WATER WELL OWNER:

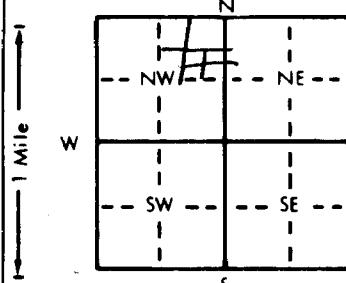
Jeff NussAugusta KS

RR#, St. Address, Box #:

1626 Highland Dr. 67010

Board of Agriculture, Division of Water Resources

City, State, ZIP Code:

3 LOCATE WELL'S LOCATION WITH
AN "X" IN SECTION BOX:4 DEPTH OF COMPLETED WELL: 147 ft. ELEVATION: _____Depth(s) Groundwater Encountered 1 85 ft. 2. _____ ft. 3. _____ ft.WELL'S STATIC WATER LEVEL 25 ft. below land surface measured on mo/day/yr

Pump test data: Well water was _____ ft. after _____ hours pumping _____ gpm

Est. Yield 10 gpm: Well water was _____ ft. after _____ hours pumping _____ gpmBore Hole Diameter 4.5 in. to _____ ft., and _____ in. to _____ ft.

WELL WATER TO BE USED AS: 5 Public water supply 8 Air conditioning 11 Injection well

1 Domestic 3 Feedlot 6 Oil field water supply 9 Dewatering 12 Other (Specify below)

2 Irrigation 4 Industrial 7 Lawn and garden only 10 Monitoring well

Was a chemical/bacteriological sample submitted to Department? Yes _____ No If yes, mo/day/yr sample was submittedWater Well Disinfected? Yes No

5 TYPE OF BLANK CASING USED:

1 Steel 3 RMP (SR)
 2 PVC 4 ABS

5 Wrought iron

6 Asbestos-Cement

7 Fiberglass

8 Concrete tile

9 Other (specify below)

CASING JOINTS: Glued Clamped _____

Welded _____

Threaded _____

Blank casing diameter 5 in. to 40 ft., Dia. _____ in. to _____ ft., Dia. _____ in. to _____ ft.Casing height above land surface 18 in., weight 160 lbs./ft. Wall thickness or gauge No. 214

TYPE OF SCREEN OR PERFORATION MATERIAL:

1 Steel 3 Stainless steel
 2 Brass 4 Galvanized steel

5 Fiberglass

6 Concrete tile

7 Gauzed wrapped

8 RMP (SR)

9 ABS

10 Asbestos-cement

11 Other (specify) _____

12 None used (open hole)

SCREEN OR PERFORATION OPENINGS ARE:

1 Continuous slot 3 Mill slot
 2 Louvered shutter 4 Key punched

5 Wire wrapped

6 Drilled holes

7 Torch cut

1 PVC

8 Saw cut

9 Gauzed wrapped

10 Other (specify) _____

11 None (open hole)

SCREEN-PERFORATED INTERVALS: From 40 ft. to 147 ft., From _____ ft. to _____ ft.

From _____ ft. to _____ ft., From _____ ft. to _____ ft.

GRAVEL PACK INTERVALS: From _____ ft. to _____ ft., From _____ ft. to _____ ft.

From _____ ft. to _____ ft., From _____ ft. to _____ ft.

6 GROUT MATERIAL: 1 Neat cement 2 Cement grout 3 Bentonite 4 Other _____

Grout Intervals: From 3 ft. to 23 ft., From _____ ft. to _____ ft., From _____ ft. to _____ ft.

What is the nearest source of possible contamination:

1 Septic tank 4 Lateral lines
 2 Sewer lines 5 Cess pool
 3 Watertight sewer lines 6 Seepage pit

7 Pit privy

8 Sewage lagoon

9 Feedyard

10 Livestock pens

11 Fuel storage

12 Fertilizer storage

13 Insecticide storage

14 Abandoned water well

15 Oil well/Gas well

16 Other (specify below)

Direction from well?

5

How many feet?

1507 CONTRACTOR'S OR LANDOWNER'S CERTIFICATION: This water well was constructed, (2) reconstructed, or (3) plugged under my jurisdiction and was completed on (mo/day/year) 8/20/01 and this record is true to the best of my knowledge and belief. KansasWater Well Contractor's License No. 357 This Water Well Record was completed on (mo/day/year) 8/27/01under the business name of Winter Well Drilling by (signature) Charles Winter