

027049

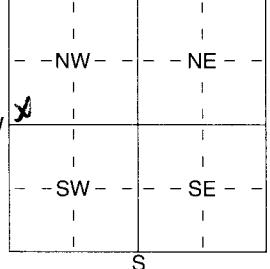
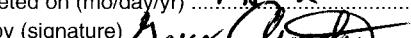
WATER WELL RECORD

Form WWC-5

KSA 82a-1212

ID No

F-6

| | | | | | | | | |
|--|--|---|--|-----------------------------|--------------------------------|--|--------------------|--|
| 1 | LOCATION OF WATER WELL: | Fraction County: Butler | SW $\frac{1}{4}$ SW $\frac{1}{4}$ NW $\frac{1}{4}$ | Section Number 22 | Township Number 27 S | Range Number R 4 E/W | | |
| Distance and direction from nearest town or city street address of well if located within city? ~300 ft. W. 1315 Money St. Augusta, KS | | | | | | | | |
| 2 | WATER WELL OWNER: | Kaneo Pipeline | | | | | | |
| RR#, St. Address, Box # : 1624 W Sunset Rd. | | | Board of Agriculture, Division of Water Resources | | | | | |
| City, State, ZIP Code : El Dorado, KS 67042 | | | Application Number: | | | | | |
| 3 | LOCATE WELL'S LOCATION WITH AN "X" IN SECTION BOX: | 4 DEPTH OF COMPLETED WELL 13 ft. ELEVATION:  Depth(s) Groundwater Encountered 1 ft. 2 ft. 3 ft. WELL'S STATIC WATER LEVEL ft. below land surface measured on mo/day/yr Pump test data: Well water was ft. after hours pumping gpm Est. Yield gpm: Well water was ft. after hours pumping gpm WELL WATER TO BE USED AS: 5 Public water supply 8 Air conditioning 11 Injection well 1 Domestic 3 Feedlot 6 Oil field water supply 9 Dewatering 12 Other (Specify below) 2 Irrigation 4 Industrial 7 Domestic (lawn & garden) 10 Monitoring well Was a chemical/bacteriological sample submitted to Department? Yes No If yes, mo/day/yr sample was submitted Water Well Disinfected? Yes Yes No No | | | | | | |
| 5 | TYPE OF BLANK CASING USED: | 1 Steel 2 PVC | 3 RMP (SR) | 5 Wrought iron | 8 Concrete tile | CASING JOINTS: Glued Clamped | | |
| | | 4 ABS | | 6 Asbestos-Cement | 9 Other (specify below) | Welded Threaded Flush | | |
| | Blank casing diameter | 2 | in. to | 2 ft., Dia | in. to | ft., Dia in. to ft. | | |
| | Casing height above land surface | Flush | in., weight | .703 | lbs./ft. | Wall thickness or guage No. .0640 | | |
| | TYPE OF SCREEN OR PERFORATION MATERIAL: | 1 Steel | 3 Stainless Steel | 5 Fiberglass | 7 PVC | 10 Asbestos-Cement | | |
| | 2 Brass | 4 Galvanized Steel | 6 Concrete tile | 8 RMP (SR) | 11 Other (Specify) | | | |
| | | | | 9 ABS | 12 None used (open hole) | | | |
| | SCREEN OR PERFORATION OPENINGS ARE: | 1 Continuous slot | 3 Mill slot | 5 Guazed wrapped | 8 Saw cut | 11 None (open hole) | | |
| | 2 Louvered shutter | 4 Key punched | | 6 Wire wrapped | 9 Drilled holes | | | |
| | | | | 7 Torch cut | 10 Other (specify) | ft. | | |
| | SCREEN-PERFORATED INTERVALS: | From | 3 | ft. to | 12 ft., From | ft. to ft. | | |
| | | From | | ft. to | ft., From | ft. to ft. | | |
| | GRAVEL PACK INTERVALS: | From | 2 | ft. to | 13 ft., From | ft. to ft. | | |
| | | From | | ft. to | ft., From | ft. to ft. | | |
| 6 | GROUT MATERIAL: | 1 Neat cement | 2 Cement grout | 3 Bentonite | 4 Other | | | |
| | Grout Intervals: | From 1 | ft. to 2 | ft., From | ft. to ft., From | ft. to ft. | | |
| | What is the nearest source of possible contamination: | 1 Septic tank | 4 Lateral lines | 7 Pit privy | 10 Livestock pens | 14 Abandoned water well | | |
| | 2 Sewer lines | 5 Cess pool | 8 Sewage lagoon | 11 Fuel storage | 15 Oil well/Gas well | | | |
| | 3 Watertight sewer lines | 6 Seepage pit | 9 Feedyard | 12 Fertilizer storage | 16 Other (specify below) | | | |
| | | | | 13 Insecticide storage | | | | |
| | Direction from well? | How many feet? | | | | | | |
| | FROM | TO | LITHOLOGIC LOG | | FROM | TO | PLUGGING INTERVALS | |
| | 0 | 6' | Clay brown silty, dry | | | | | |
| | 6' | 13' | Clay, grey, wet | | | | | |
| 7 | CONTRACTOR'S OR LANDOWNER'S CERTIFICATION: This water well was (1) constructed, (2) reconstructed, or (3) plugged under my jurisdiction and was completed on (mo/day/year) 8-2-02 | and this record is true to the best of my knowledge and belief. Kansas | | | | | | |
| | Water Well Contractor's Licence No 531 | This Water Well Record was completed on (mo/day/yr) 9-8-02 | | | | | | |
| | under the business name of Geotechnical Services Inc. | by (signature)  | | | | | | |

7 CONTRACTOR'S OR LANDOWNER'S CERTIFICATION: This water well was (1) constructed, (2) reconstructed, or (3) plugged under my jurisdiction and was completed on (mo/day/year) 8-2-02 and this record is true to the best of my knowledge and belief. Kansas
Water Well Construction Record Form 31

Water Well Contractor's Licence No 531 This Water Well Record was completed on (mo/day/yr) 9-8-02
under the business name of Geotechnical Services Inc. by (signature) James P. [Signature]

INSTRUCTIONS: Use typewriter or ball point pen. PLEASE PRESS FIRMLY and PRINT clearly. Please fill in blanks, underline or circle the correct answers. Send top three copies to Kansas Department of Health and Environment, Bureau of Water, Geology Section, 1000 SW Jackson St., Suite 420, Topeka, Kansas 66612-1367. Telephone 785-296-5522. Send one to WATER WELL OWNER and retain one for your records. Fee of \$5.00 for each constructed well.