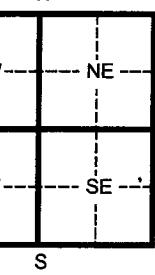
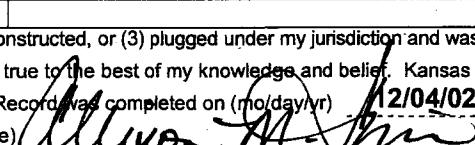


**WATER WELL RECORD** Form WWC-5 KSA 82a-1212 ID No.

1 LOCATION OF WATER WELL:		Fraction County: Butler NW $\frac{1}{4}$ SW $\frac{1}{4}$ NW $\frac{1}{4}$	Section Number 22	Township Number T 27 S	Range Number R 04 E/W	
Distance and direction from nearest town or city street address of well if located within city? <b>Approx. 225 ft. S of Kelly &amp; Approx. 135 ft. E of Dike Road (north side of levee), Augusta</b>						
2 WATER WELL OWNER: <b>Kaneb Pipeline</b> RR#, St. Address, Box #: <b>1624 W. Sunset Rd.</b> City, State, ZIP Code: <b>El Dorado, KS 67042</b>			Board of Agriculture, Division of Water Resources Application Number:			
3 LOCATE WELL'S LOCATON WITH AN "X" IN SECTION BOX:		4 DEPTH OF COMPLETED WELL Depth(s) Groundwater Encountered 1 <b>14.5</b> ft. 2 <b>17.5</b> ft. 3 <b>17.5</b> ft. ft. below land surface measured on mo/day/yr				
sample submitted to Department? Yes <b>No X</b> If yes, mo/day/yr sample was submitted Water Well Disinfected? Yes <b>No X</b>				
5 TYPE OF BLANK CASING USED: 1 Steel 3 RMP (SR) 5 Wrought Iron 8 Concrete tile CASING JOINTS: Glued Clamped 2 PVC 4 ABS 6 Asbestos-Cement 9 Other (specify below) Welded Blank casing diameter <b>2</b> in. to <b>7.5</b> ft., Dia <b>0.703</b> in. to ft., Dia in. to ft. Casing height above land surface <b>Flush</b> in., weight <b>0.703</b> lbs./ft. Wall thickness or gauge No. <b>Sch. 40</b>						
6 TYPE OF SCREEN OR PERFORATION MATERIAL: 1 Steel 3 Stainless steel 5 Fiberglass 10 Asbestos-cement 2 Brass 4 Galvanized steel 6 Concrete tile 8 RMP (SR) 11 Other (specify) 7 PVC 7 Fiberglass 9 ABS 12 None used (open hole) SCREEN OR PERFORATION OPENINGS ARE: 1 Continuous slot 3 Mill slot 5 Gauzed wrapped 8 Saw cut 11 None (open hole) 2 Louvered shutter 4 Key punched 6 Wire wrapped 9 Drilled holes 7 Torch cut 10 Other (specify)						
SCREEN-PERFORATED INTERVALS: From <b>7.5</b> ft. to <b>17.5</b> ft. From ft. to ft. GRAVEL PACK INTERVALS: From <b>6.5</b> ft. to <b>17.5</b> ft. From ft. to ft. From ft. to ft. From ft. to ft. From ft. to ft. From ft. to ft.						
7 GROUT MATERIAL: 1 Neat cement 2 Cement grout 3 Bentonite 4 Other <b>Concrete</b> Grout Intervals From <b>0</b> ft. to <b>1</b> ft. From <b>1</b> ft. to <b>6.5</b> ft. From ft. to ft. What is the nearest source of possible contamination: 1 Septic tank 4 Lateral lines 7 Pit privy 10 Livestock pens 14 Abandoned water well 2 Sewer lines 5 Cess pool 8 Sewage lagoon 11 Fuel storage 15 Oil well/ Gas well 3 Watertight sewer lines 6 Seepage pit 9 Feedyard 12 Fertilizer storage 16 Other (specify below)						
Direction from well? How many feet?						
FROM	TO	CODE	LITHOLOGIC LOG	FROM	TO	PLUGGING INTERVALS
<b>0</b>	<b>9.5</b>		<b>Clay, dark brown</b>			
<b>9.5</b>	<b>13</b>		<b>Sandy Clay, dark brown</b>			
<b>13</b>	<b>17.5</b>		<b>Sandy Clay, gray</b>			
7 CONTRACTOR'S OR LANDOWNER'S CERTIFICATION: This water well was <b>(1) constructed</b> <b>(2) reconstructed</b> , or <b>(3) plugged</b> under my jurisdiction and was completed on (mo/day/yr) <b>11-13-02</b> and this record is true to the best of my knowledge and belief, Kansas						
Water Well Contractor's License No. <b>531</b>			This Water Well Record was completed on (mo/day/yr) <b>12/04/02</b>			
Under the business name of <b>Geotechnical Services, Inc.</b> by (signature) 						
INSTRUCTIONS: Please fill in blanks and circle the correct answers. Send three copies to Kansas Department of Health and Environment, Bureau of Water, 1000 S W Jackson St., Ste. 120, Topeka, Kansas 66612-1367. Telephone: 913-296-5515. Send one to WATER WELL OWNER and retain one for your records.						

7] CONTRACTOR'S OR LANDOWNER'S CERTIFICATION: This water well was (1) constructed (2) reconstructed, or (3) plugged under my jurisdiction and was completed on (mo/day/yr) **11-13-02** and this record is true to the best of my knowledge and belief. Kansas

**Water Well Contractor's License No.**

531

This Water Well Record was completed on (mo/day/yr)

12/04/02

under the business name of

1 Se

by (signature) 

Bar)

**INSTRUCTIONS:** Please

and circle the correct answers. Send three

5, (Signature)  
Kansas Department

Jackson St., Ste. 420, Topeka, Kansas 66612-1367. Telephone: 913-296-5545. Send one to WATER WELL OWNER and retain one for your records.