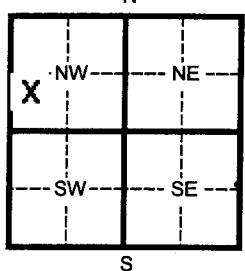
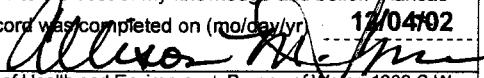


WATER WELL RECORD Form WWC-5 KSA 82a-1212 ID No.

1 LOCATION OF WATER WELL:			Fraction Butler County: NW 1/4 SW 1/4 NW 1/4	Section Number 22	Township Number T 27 S	Range Number R 04 E/W
Distance and direction from nearest town or city street address of well if located within city? Approx. 565 ft. S of Kelly between Dike Road & Augusta Flood Levee, Augusta						
2 WATER WELL OWNER: Kaneb Pipeline RR#, St. Address, Box #: 1624 W. Sunset Rd. City, State, ZIP Code: El Dorado, KS 67042			Board of Agriculture, Division of Water Resources Application Number:			
3 LOCATE WELL'S LOCATON WITH AN "X" IN SECTION BOX:		4 DEPTH OF COMPLETED WELL 17 ft. ELEVATION: Depth(s) Groundwater Encountered 1 ft. 2 ft. 3 ft. WELL'S STATIC WATER LEVEL ft. below land surface measured on mo/day/yr Pump test data: Well water was ft. after hours pumping gpm Est. Yield gpm: Well water was ft. after hours pumping gpm Bore Hole Diameter 8.5 in. to 17 ft. and in. to ft. WELL WATER TO BE USED AS: 5 Public water supply 8 Air conditioning 11 Injection well 1 Domestic 3 Feed lot 6 Oil field water supply 9 Dewatering 12 Other (Specify below) 2 Irrigation 4 Industrial 7 Lawn and garden (domestic) 10 Monitoring well				
		Was a chemical/bacteriological sample submitted to Department? Yes No X If yes, mo/day/yr sample was submitted Water Well Disinfected? Yes No X				
5 TYPE OF BLANK CASING USED:			5 Wrought Iron 6 Asbestos-Cement 7 Fiberglass	8 Concrete tile 9 Other (specify below)	CASING JOINTS: Glued _____ Clamped _____ Welded Flush Threaded	
Blank casing diameter 2 in. to 7 ft., Dia			in. to	ft., Dia	in. to	ft.
Casing height above land surface Flush in., weight 0.703			lbs./ft. Wall thickness or gauge No. 7 PVC	Sch. 40		
TYPE OF SCREEN OR PERFORATION MATERIAL:						
1 Steel 3 Stainless steel 5 Fiberglass 2 Brass 4 Galvanized steel 6 Concrete tile			7 Gauzed wrapped 8 Wire wrapped 9 Torch cut	10 Asbestos-cement 11 Other (specify) 12 None used (open hole)		
SCREEN OR PERFORATION OPENINGS ARE: 1 Continuous slot 3 Mill slot 2 Louvered shutter 4 Key punched			8 Saw cut 9 Drilled holes 10 Other (specify)	11 None (open hole)		
SCREEN-PERFORATED INTERVALS: From 7 ft. to 17 ft. From _____ ft. to _____ ft.			From _____ ft. to _____ ft.			
GRAVEL PACK INTERVALS: From 6 ft. to 17 ft. From _____ ft. to _____ ft.			From _____ ft. to _____ ft.			
6 GROUT MATERIAL: 1 Neat cement 2 Cement grout 3 Bentonite 4 Other Concrete						
Grout Intervals From 0 ft. to 1 ft. From 1 ft. to 6 ft. From _____ ft. to _____ ft.			10 Livestock pens 11 Fuel storage 12 Fertilizer storage 13 Insecticide storage	14 Abandoned water well 15 Oil well/ Gas well 16 Other (specify below)		
What is the nearest source of possible contamination: 1 Septic tank 4 Lateral lines 7 Pit privy 2 Sewer lines 5 Cess pool 8 Sewage lagoon 3 Watertight sewer lines 6 Seepage pit 9 Feedyard						
Direction from well? How many feet?						
FROM 0	TO 1	CODE Topsoil	LITHOLOGIC LOG		FROM 1	TO 6
1	5	Clay, brown				
5	17	Clay, red brown				
7 CONTRACTOR'S OR LANDOWNER'S CERTIFICATION: This water well was 1 constructed 2 reconstructed, or 3 plugged under my jurisdiction and was completed on (mo/day/yr) 11-12-02 and this record is true to the best of my knowledge and belief. Kansas Water Well Contractor's License No. 531 This Water Well Record was completed on (mo/day/yr) 12/04/02						
under the business name of Geotechnical Services, Inc. by (signature) 						
INSTRUCTIONS: Please fill in Blanks and circle the correct answers. Send three copies to Kansas Department of Health and Environment, Bureau of Water, 1000 S W Jackson St., Ste. 420, Topeka, Kansas 66612-1367. Telephone: 913-296-5545. Send one to WATER WELL OWNER and retain one for your records.						