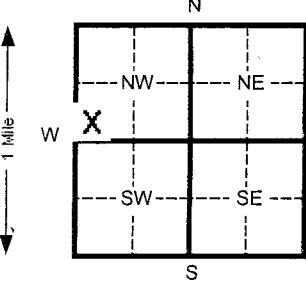


WATER WELL RECORD Form WWC-5 KSA 82a-1212 ID No.

1 LOCATION OF WATER WELL: County: Butler		Fraction SW 1/4 SW 1/4 NW 1/4	Section Number 22	Township Number 27	Range Number R 4	Range Number EW	
Distance and direction from nearest town or city street address of well if located within city? ~300' West 1315 Money Street							
2 WATER WELL OWNER: RR#, St. Address, Box # City, State, ZIP Code		KANE Pipeline 1624 West Sunset Road El Dorado, KS 67042					Board of Agriculture, Division of Water Resources Application Number:
3 LOCATE WELL'S LOCATON WITH AN "X" IN SECTION BOX:		4 DEPTH OF COMPLETED WELL Depth(s) Groundwater Encountered 1					16 ft. ELEVATION: ft. 2 ft. 3 ft.
		WELL'S STATIC WATER LEVEL Pump test data: Well water was ft. after hours pumping gpm Est. Yield gpm: Well water was ft. after hours pumping gpm					
		Bore Hole Diameter 8.5 in. to 16 ft. and in. to ft. WELL WATER TO BE USED AS: 5 Public water supply 8 Air conditioning 11 Injection well 1 Domestic 3 Feed lot 6 Oil field water supply 9 Dewatering 12 Other (Specify below) 2 Irrigation 4 Industrial 7 Lawn and garden (domestic) 10 Monitoring well					
		Was a chemical/bacteriological sample submitted to Department? Yes No X If yes, mo/day/yr sample was submitted					Water Well Disinfected? Yes No X
5 TYPE OF BLANK CASING USED: 1 Steel 2 PVC		5 Wrought Iron 8 Concrete tile Casing JOINTS: Glued 3 RMP (SR) 6 Asbestos-Cement 9 Other (specify below) Clamped 4 ABS 7 Fiberglass Welded Threaded					Flush
Blank casing diameter 2 in. to 6		ft., Dia in. to ft., Dia in. to ft.					
Casing height above land surface 36 in., weight 0.703		lbs./ft. Wall thickness or gauge No.					Sch. 40
TYPE OF SCREEN OR PERFORATION MATERIAL: 1 Steel 2 Brass		7 PVC 10 Asbestos-cement 3 Stainless steel 5 Fiberglass 8 RMP (SR) 11 Other (specify) 4 Galvanized steel 6 Concrete tile 9 ABS 12 None used (open hole)					
SCREEN OR PERFORATION OPENINGS ARE: 1 Continuous slot 2 Louvered shutter		5 Gauzed wrapped 8 Saw cut 11 None (open hole) 3 Mill slot 6 Wire wrapped 9 Drilled holes 4 Key punched 7 Torch cut 10 Other (specify)					
SCREEN-PERFORATED INTERVALS: From 6 ft. to 16 ft. From		ft. From ft. to ft.					
GRAVEL PACK INTERVALS: From 4 ft. to 16 ft. From		ft. From ft. to ft.					
6 GROUT MATERIAL: 1 Neat cement 2 Cement grout		3 Bentonite 4 Other					
Grout Intervals From 1 ft. to 4 ft. From		ft. to ft. From ft. to ft.					
What is the nearest source of possible contamination: 1 Septic tank 4 Lateral lines 7 Pit privy 10 Livestock pens 14 Abandoned water well 2 Sewer lines 5 Cess pool 8 Sewage lagoon 11 Fuel storage 15 Oil well/ Gas well 3 Watertight sewer lines 6 Seepage pit 9 Feedyard 12 Fertilizer storage 16 Other (specify below)							
Direction from well? How many feet?							
FROM	TO	CODE	LITHOLOGIC LOG		FROM	TO	PLUGGING INTERVALS
0	7.5		Clay brown				
7.5	16		Weathered clay shale				
7 CONTRACTOR'S OR LANDOWNER'S CERTIFICATION: This water well was (1) constructed (2) reconstructed, or (3) plugged under my jurisdiction and was completed on (mo/day/yr) 08/07/03 and this record is true to the best of my knowledge and belief. Kansas							
Water Well Contractor's License No.		531					This Water Well Record was completed on (mo/day/yr) 9-29-03
under the business name of		Geotechnical Services Inc.					by (signature) <i>Alvaro M. Diaz</i>

INSTRUCTIONS: Please fill in blanks and circle the correct answers. Send three copies to Kansas Department of Health and Environment, Bureau of Water, 1000 S W Jackson St., Ste. 420, Topeka, Kansas 66612-1367. Telephone: 913-296-5545. Send one to WATER WELL OWNER and retain one for your records.