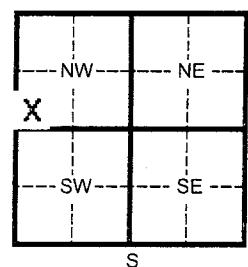
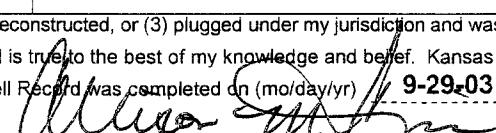


## WATER WELL RECORD Form WWC-5 KSA 82a-1212 ID No. \_\_\_\_\_

1 LOCATION OF WATER WELL:		Fraction <b>SW 1/4 SW 1/4 NW 1/4</b>	Section Number <b>22</b>	Township Number <b>27</b>	Range Number <b>R 4</b>	Range Number <b>EW</b>
Distance and direction from nearest town or city street address of well if located within city? <b>~300' West 1315 Money Street</b>						
2 WATER WELL OWNER: <b>KANE Pipeline</b> <b>1624 West Sunset Road</b> <b>EI Dorado, KS 67042</b>						
Board of Agriculture, Division of Water Resources Application Number: _____						
3 LOCATE WELL'S LOCATON WITH AN "X" IN SECTION BOX:						
		4 DEPTH OF COMPLETED WELL <b>15.5</b> ft. ELEVATION: Depth(s) Groundwater Encountered 1 ft. 2 ft. 3 ft. WELL'S STATIC WATER LEVEL ft. below land surface measured on mo/day/yr Pump test data: Well water was ft. after hours pumping gpm Est. Yield gpm: Well water was ft. after hours pumping gpm Bore Hole Diameter <b>8.5</b> in. to <b>15.5</b> ft. and in. to ft. WELL WATER TO BE USED AS: 5 Public water supply 8 Air conditioning 11 Injection well 1 Domestic 3 Feed lot 6 Oil field water supply 9 Dewatering 12 Other (Specify below) 2 Irrigation 4 Industrial 7 Lawn and garden (domestic) 10 Monitoring well Was a chemical/bacteriological sample submitted to Department? Yes No <b>X</b> If yes, mo/day/yr sample was submitted Water Well Disinfected? Yes No <b>X</b>				
5 TYPE OF BLANK CASING USED:						
1 Steel		3 RMP (SR)	5 Wrought Iron	8 Concrete tile	CASING JOINTS: Glued Clamped	
2 <b>PVC</b>		4 ABS	6 Asbestos-Cement	9 Other (specify below)	Welded Threaded <b>Flush</b>	
Blank casing diameter <b>2</b>		in. to <b>5.5</b>	ft., Dia	in. to	ft., Dia	in. to ft.
Casing height above land surface <b>36</b>		in., weight <b>0.703</b>		lbs./ft.	Wall thickness or gauge No.	<b>Sch. 40</b>
TYPE OF SCREEN OR PERFORATION MATERIAL:						
1 Steel		3 Stainless steel	5 Fiberglass	7 <b>PVC</b>	10 Asbestos-cement	
2 Brass		4 Galvanized steel	6 Concrete tile	8 RMP (SR)	11 Other (specify)	
SCREEN OR PERFORATION OPENINGS ARE:		3 <b>Mill slot</b>	5 Gauzed wrapped	9 ABS	12 None used (open hole)	
1 Continuous slot		6 Wire wrapped	8 Saw cut	10 Other (specify)	11 None (open hole)	
2 Louvered shutter		7 Torch cut	9 Drilled holes			
SCREEN-PERFORATED INTERVALS: From <b>5.5</b> ft. to <b>15.5</b> ft. From ft. to ft.						
GRAVEL PACK INTERVALS: From <b>4</b> ft. to <b>15.5</b> ft. From ft. to ft.						
6 GROUT MATERIAL: 1 Neat cement 2 Cement grout <b>3 Bentonite</b> 4 Other						
Grout Intervals From <b>1</b> ft. to <b>4</b> ft. From ft. to ft. From ft. to ft.						
What is the nearest source of possible contamination:						
1 Septic tank		4 Lateral lines	7 Pit privy	10 Livestock pens	14 Abandoned water well	
2 Sewer lines		5 Cess pool	8 Sewage lagoon	11 Fuel storage	15 Oil well/ Gas well	
3 Watertight sewer lines		6 Seepage pit	9 Feedyard	12 Fertilizer storage	16 Other (specify below)	
Direction from well? How many feet?						
FROM	TO	CODE	LITHOLOGIC LOG	FROM	TO	PLUGGING INTERVALS
<b>0</b>	<b>7.5</b>		<b>Clay brown</b>			
<b>7.5</b>	<b>15.5</b>		<b>Weathered clay shale</b>			
7 CONTRACTOR'S OR LANDOWNER'S CERTIFICATION: This water well was <b>1</b> constructed, <b>2</b> reconstructed, or <b>3</b> plugged under my jurisdiction and was completed on (mo/day/yr) <b>08/07/03</b> and this record is true to the best of my knowledge and belief. Kansas Water Well Contractor's License No. <b>531</b> This Water Well Record was completed on (mo/day/yr) <b>9-29-03</b>						
under the business name of <b>Geotechnical Services Inc.</b> by (signature) 						
INSTRUCTIONS: Please fill in blanks and circle the correct answers. Send three copies to Kansas Department of Health and Environment, Bureau of Water, 1000 S W Jackson St. Ste. 420, Topeka, Kansas 66612-1367. Telephone: 913-296-5545. Send one to WATER WELL OWNER and retain one for your records.						