

1 LOCATION OF WATER WELL:	Fraction	Section Number	Township Number	Range Number
County: <i>Sutler</i>	<i>SE 1/4 NE 1/4 NW 1/4</i>	<i>15</i>	T <i>27</i> S	R <i>4</i> <i>EN</i>


Distance and direction from nearest town or city street address of well if located within city?

2] WATER WELL OWNER: Tyler Brewer Augusta Kan  
RR#, St. Address, Box # : 517 StoneLakeCrt 67010  
City, State, ZIP Code : Boa  
App

Board of Agriculture, Division of Water Resources  
Application Number:

3 LOCATE WELL'S LOCATION WITH AN "X" IN SECTION BOX:

4 DEPTH OF COMPLETED WELL 141 ft. ELEVATION: \_\_\_\_\_  
 Depth(s) Groundwater Encountered 1 90 ft 2 \_\_\_\_\_ ft 3 \_\_\_\_\_ ft

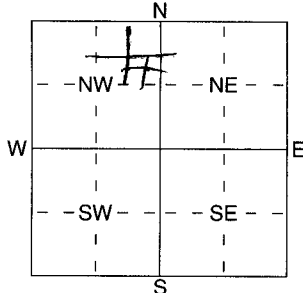

WELL'S STATIC WATER LEVEL 35 ft. below land surface measured on mo/day/yr .....

Pump test data: Well water was ..... ft. after ..... hours pumping ..... gpm

Est. Yield 7 gpm: Well water was ..... ft. after ..... hours pumping ..... gpm

WELL WATER TO BE USED AS:

1 Domestic	3 Feedlot	5 Public water supply	8 Air conditioning	11 Injection well
2 Irrigation	4 Industrial	6 Oil field water supply	9 Dewatering	12 Other (Specify below)
		7 Domestic (lawn & garden)	10 Monitoring well	

Was a chemical/bacteriological sample submitted to Department? Yes ..... No ~~.....~~ ; If yes, mo/day/yr sample was submitted  
Water Well Disinfected? Yes ~~.....~~ No

5 TYPE OF BLANK CASING USED:

5 Wrought iron	8 Concrete tile	CASING JOINTS: Glued <input checked="" type="checkbox"/> Clamped .....
6 Asbestos-Cement	9 Other (specify below)	Welded .....
7 Fiberglass	.....	Threaded .....

Blank casing diameter ..... 18 in. to 20 ft., Dia ..... 160 in. to ..... ft., Dia ..... in. to ..... ft.  
Casing height above land surface ..... 18 in., weight ..... 160 lbs./ft. Wall thickness or gauge No. 214

TYPE OF SCREEN OR PERFORATION MATERIAL:

1 Steel	3 Stainless Steel	5 Fiberglass	8 RMP (SR)	11 Other (Specify) .....
2 Brass	4 Galvanized Steel	6 Concrete tile	9 ABS	12 None used (open hole)

SCREEN OR PERFORATION OPENINGS ARE:

1 Continuous slot      3 Mill slot      6 Wire wrapped      9 Drilled holes  
2 Louvered shutter      4 Key punched      7 Torch cut      10 Other (specify) ..... ft.

SCREEN-PERFORATED INTERVALS: From 20 ft. to 171 ft., From \_\_\_\_\_ ft. to \_\_\_\_\_ ft.  
From \_\_\_\_\_ ft. to \_\_\_\_\_ ft. From \_\_\_\_\_ ft. to \_\_\_\_\_ ft.

GRAVEL PACK INTERVALS: From ..... ft. to ..... ft., From ..... ft. to ..... ft.  
From ..... ft. to ..... ft., From ..... ft. to ..... ft.

6 GROUT MATERIAL: 1 Neat cement 2 Cement grout 3 Bentonite 4 Other.....

Grout Intervals: From 3 ft. to 23 ft., From 23 ft. to 25 ft., From 25 ft. to 27 ft.

1 Septic tank	4 Lateral lines	7 Pit privy	10 Livestock pens	14 Abandoned water well
2 Sewer lines	5 Cess pool	8 Sewage lagoon	11 Fuel storage	15 Oil well/Gas well
3 Watertight sewer lines	6 Slopewat pit	9 Feedyard	12 Fertilizer storage	16 Other (specify below)

Direction from well? *W* How many feet? *100*

[illegible]

7. CONTRACTOR'S OR LANDOWNER'S CERTIFICATION: This water well was (1) constructed, (2) reconstructed, or (3) plugged under my jurisdiction and was completed on (mo/day/year) 3/6/04 and this record is true to the best of my knowledge and belief. Kansas Water Well Contractor's Licence No. 251 This Water Well Record was completed on (mo/day/yr) 3/6/04 under the business name of Winter Well Drilling by (signature) Charles Winter