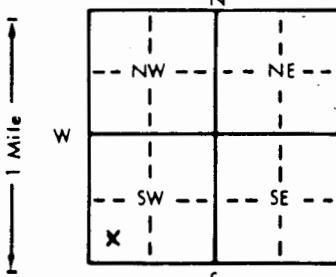


WATER WELL RECORD Form WWC-5 KSA 82a-1212

1 LOCATION OF WATER WELL:	Fraction	Section Number	Township Number	Range Number
County: <u>Butler</u>	<u>SW 1/4 SW 1/4 SW 1/4</u>	<u>11</u>	<u>T 27 S</u>	<u>R 4 E</u>

Distance and direction from nearest town or city street address of well if located within city?

Stone Lake Estates - 1/4 mile E. of Ohio & 80th Northside Tract V0 142 WATER WELL OWNER: Sharp Realty & Const.RR#, St. Address, Box # 430 Walnut St.City, State, ZIP Code Augusta KS 67010Board of Agriculture, Division of Water Resources
Application Number:3 LOCATE WELL'S LOCATION WITH X IN SECTION BOX:
AN "X" IN SECTION BOX:4 DEPTH OF COMPLETED WELL 120 ft. ELEVATION: _____Depth(s) Groundwater Encountered 1. 80 ft. 2. _____ ft. 3. _____ ft.WELL'S STATIC WATER LEVEL 30 ft. below land surface measured on mo/day/yr

Pump test data: Well water was _____ ft. after _____ hours pumping _____ gpm

Est. Yield 40 gpm: Well water was _____ ft. after _____ hours pumping _____ gpmBore Hole Diameter 12 in. to _____ ft., and _____ in. to _____ ft.

WELL WATER TO BE USED AS: 5 Public water supply 8 Air conditioning 11 Injection well

1 Domestic 3 Feedlot 6 Oil field water supply 9 Dewatering 12 Other (Specify below)

2 Irrigation 4 Industrial 7 Lawn and garden only 10 Monitoring wellWas a chemical/bacteriological sample submitted to Department? Yes NO; If yes, mo/day/yr sample was submittedWater Well Disinfected? Yes NO5 TYPE OF BLANK CASING USED: 5 Wrought iron 8 Concrete tile CASING JOINTS Glued _____ Clamped _____

1 Steel 3 RMP (SR) 6 Asbestos-Cement 9 Other (specify below) Welded _____

PVC 4 ABS 7 Fiberglass Threaded _____Blank casing diameter 5 in. to _____ ft., Dia _____ in. to _____ ft., Dia _____ in. to _____ ft.Casing height above land surface 12 in., weight 160 lbs./ft. Wall thickness or gauge No. _____6 TYPE OF SCREEN OR PERFORATION MATERIAL: PVC 10 Asbestos-cement

1 Steel 3 Stainless steel 5 Fiberglass 8 RMP (SR) 11 Other (specify) _____

2 Brass 4 Galvanized steel 6 Concrete tile 9 ABS 12 None used (open hole) _____

SCREEN OR PERFORATION OPENINGS ARE: 5 Gauzed wrapped 8 Saw cut 11 None (open hole)

1 Continuous slot 3/4 in. slot 6 Wire wrapped 9 Drilled holes

2 Louvered shutter 4 Key punched 7 Torch cut 10 Other (specify) _____

SCREEN-PERFORATED INTERVALS: From 80 ft. to 120 ft., From _____ ft. to _____ ft.

From _____ ft. to _____ ft., From _____ ft. to _____ ft.

GRAVEL PACK INTERVALS: From 20 ft. to 120 ft., From _____ ft. to _____ ft.

From _____ ft. to _____ ft., From _____ ft. to _____ ft.

6 GROUT MATERIAL: 1 Neat cement 2 Cement grout 3 Bentonite 4 Other _____Grout Intervals: From 3 ft. to 20 ft., From _____ ft. to _____ ft., From _____ ft. to _____ ft.

What is the nearest source of possible contamination:

1 Septic tank 4 Lateral lines 7 Pit privy 10 Livestock pens 14 Abandoned water well

2 Sewer lines 5 Cess pool 8 Sewage lagoon 11 Fuel storage 15 Oil well/Gas well

3 Watertight sewer lines 6 Seepage pit 9 Feedyard 12 Fertilizer storage 16 Other (specify below)

13 Insecticide storage _____

How many feet? 154

Direction from well?

FROM	TO	LITHOLOGIC LOG	FROM	TO	PLUGGING INTERVALS
0	4	earth			
4	15	clay (brown)			
15	20	yellow clay			
20	90	shale (red)			
90	120	gray shale			