

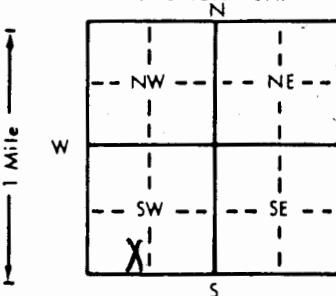
WATER WELL RECORD Form WWC-5 KSA 82a-1212

1. LOCATION OF WATER WELL:	Fraction County: Butler	SE $\frac{1}{4}$ SW $\frac{1}{4}$ SW $\frac{1}{4}$	Section Number 11	Township Number T 27 S	Range Number R 4 E
----------------------------	-----------------------------------	--	----------------------	---------------------------	-----------------------

Distance and direction from nearest town or city street address of well if located within city?

Stone Lakes Estates - 1/4 mile E of Ohio + 80± Northside Tract V09 well#22. WATER WELL OWNER: **Sharp Realty & Const.**
RR#, St. Address, Box #: **430 Walnut St.**
City, State, ZIP Code: **Augusta KS 67010**Board of Agriculture, Division of Water Resources
Application Number:

3. LOCATE WELL'S LOCATION WITH AN "X" IN SECTION BOX:

4. DEPTH OF COMPLETED WELL: **115** ft. ELEVATION:Depth(s) Groundwater Encountered 1. **90** ft. 2. ft. 3. ft.WELL'S STATIC WATER LEVEL **30** ft. below land surface measured on mo/day/yr

Pump test data: Well water was ft. after hours pumping gpm

Est. Yield **30** gpm: Well water was ft. after hours pumping gpmBore Hole Diameter **12** in. to ft. and in. to ft.

WELL WATER TO BE USED AS: 5 Public water supply 8 Air conditioning 11 Injection well

1 Domestic 3 Feedlot 6 Oil field water supply 9 Dewatering 12 Other (Specify below)

2 Irrigation 4 Industrial **7** Lawn and garden only 10 Monitoring well

Was a chemical/bacteriological sample submitted to Department? Yes No If yes, mo/day/yr sample was submitted

Water Well Disinfected? Yes No

5. TYPE OF BLANK CASING USED:

1 Steel 3 RMP (SR)
2 PVC 4 ABS5 Wrought iron 8 Concrete tile
6 Asbestos-Cement 9 Other (specify below)CASING JOINTS: **Glued** Clamped

Welded

Threaded

Blank casing diameter **5** in. to ft., Dia in. to ft., Dia in. to ft.Casing height above land surface **12** in., weight **160** lbs./ft. Wall thickness or gauge No.

6. TYPE OF SCREEN OR PERFORATION MATERIAL:

1 Steel 3 Stainless steel
2 Brass 4 Galvanized steel5 Fiberglass 6 Concrete tile
7 Fiberglass

10 Asbestos-cement

11 Other (specify)

12 None used (open hole)

SCREEN OR PERFORATION OPENINGS ARE:

1 Continuous slot **3 Mill slot**
2 Louvered shutter 4 Key punched

5 Gauzed wrapped

8 Saw cut 11 None (open hole)

6 Wire wrapped

9 Drilled holes

7 Torch cut

10 Other (specify)

SCREEN-PERFORATED INTERVALS: From **90** ft. to **115** ft., From ft. to ft.

From ft. to ft., From ft. to ft.

GRAVEL PACK INTERVALS: From **20** ft. to **115** ft., From ft. to ft.

From ft. to ft., From ft. to ft.

6. GROUT MATERIAL: 1 Neat cement 2 Cement grout **3 Bentonite** 4 OtherGrout Intervals: From **3** ft. to **20** ft., From ft. to ft., From ft. to ft.

What is the nearest source of possible contamination:

1 Septic tank 4 Lateral lines
2 Sewer lines 5 Cess pool
3 Watertight sewer lines 6 Seepage pit7 Pit privy 8 Sewage lagoon
9 Feedyard

10 Livestock pens 14 Abandoned water well

11 Fuel storage 15 Oil well/Gas well

12 Fertilizer storage 16 Other (specify below)

13 Insecticide storage

How many feet? **20+**

Direction from well?

FROM TO LITHOLOGIC LOG FROM TO PLUGGING INTERVALS

0	3	Dirt			
3	20	brown clay			
20	75	Yellow clay			
75	90	shaly lime			
90	115	gray shale			

RECEIVED

SEP 01 2004

BUREAU OF WATER

7. CONTRACTOR'S OR LANDOWNER'S CERTIFICATION: This water well was **1** constructed, **2** reconstructed, or **3** plugged under my jurisdiction and was completed on (mo/day/year) **8/1/04** and this record is true to the best of my knowledge and belief. KansasWater Well Contractor's License No. **453** This Water Well Record was completed on (mo/day/yr) **8/1/04** by (signature) **James Reissner**

INSTRUCTIONS: Use typewriter or ball point pen. PLEASE PRESS FIRMLY and PRINT clearly. Please fill in blanks, underline or circle the correct answers. Send top three copies to Kansas Department of Health and Environment, Bureau of Water, Topeka, Kansas 66620-0001. Telephone: 913-296-5545. Send one to WATER WELL OWNER and retain one for your records.