

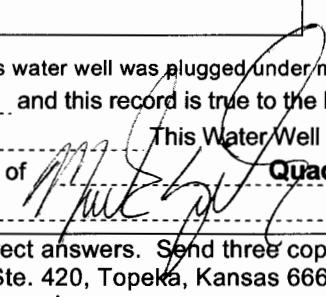
WATER WELL PLUGGING RECORD

Form WWC-5P

KSA 82a-1212

ID No.

MW-1

1 LOCATION OF WATER WELL:		Fraction County: Butler NE $\frac{1}{4}$ NW $\frac{1}{4}$ NE $\frac{1}{4}$	Section Number 27	Township Number 27	Range Number 4-East	
Distance and direction from nearest town or city street address of well if located within city? 133 E. 7th Street, Augusta, Kansas	
2 WATER WELL OWNER:		Shirley Baugher RR#, St. Address, Box # P.O. Box 56	
City, State, ZIP Code :		Augusta, Kansas 67010	
3 MARK WELL'S LOCATON WITH AN "X" IN SECTION BOX:		<table border="1" style="float: left; margin-right: 10px;"> <tr><td colspan="2" style="text-align: center;">N</td></tr> <tr><td style="text-align: center;">W</td><td style="text-align: center;">X</td></tr> <tr><td colspan="2" style="text-align: center;">E</td></tr> <tr><td style="text-align: center;">S</td><td style="text-align: center;">SW NE NE SE</td></tr> <tr><td colspan="2" style="text-align: center;">W</td></tr> </table> 4 DEPTH OF WELL 15.0 ft. WELL'S STATIC WATER LEVEL 9.29 ft. WELL WAS USED AS:				N		W	X	E		S	SW NE NE SE	W	
N	
W	X	
E	
S	SW NE NE SE	
W	
		<table border="0"> <tr><td>1 Domestic</td><td>5 Public Water Supply</td><td>9 Dewatering</td></tr> <tr><td>2 Irrigation</td><td>6 Oil Field Water Supply</td><td>10 Monitoring Well</td></tr> <tr><td>3 Feedlot</td><td>7 Lawn and Garden (domestic)</td><td>11 Injection Well</td></tr> <tr><td>4 Industrial</td><td>8 Air Conditioning</td><td>12 Other</td></tr> </table>				1 Domestic	5 Public Water Supply	9 Dewatering	2 Irrigation	6 Oil Field Water Supply	10 Monitoring Well	3 Feedlot	7 Lawn and Garden (domestic)	11 Injection Well	4 Industrial	8 Air Conditioning	12 Other	
1 Domestic	5 Public Water Supply	9 Dewatering	
2 Irrigation	6 Oil Field Water Supply	10 Monitoring Well	
3 Feedlot	7 Lawn and Garden (domestic)	11 Injection Well	
4 Industrial	8 Air Conditioning	12 Other	
		Was a chemical/bacteriological sample submitted to Department? If yes, mo/day/yr sample was submitted Water Well Disinfected: Yes <input type="checkbox"/> No <input checked="" type="checkbox"/>	
5 TYPE OF BLANK CASING USED:		1 Steel <input type="checkbox"/>	3 RMP (SR) <input type="checkbox"/>	5 Wrought <input type="checkbox"/>	7 Fiberglass <input type="checkbox"/>	
		2 PVC <input checked="" type="checkbox"/>	4 ABC <input type="checkbox"/>	6 Asbestos-Cement <input type="checkbox"/>	8 Concrete Tile <input type="checkbox"/>	
Blank casing diameter		2.375 in.	Was casing pulled?	Yes <input checked="" type="checkbox"/>	No <input type="checkbox"/>	
Casing height above or below land surface		Unknown in.	If yes, how much? 15'	
6 GROUT PLUG MATERIAL:		1 Neat cement	2 Cement grout	3 Bentonite	4 Other	
Grout Plug Intervals		From 15.0 ft. to 3.0 ft.	From 3.0 ft. to 0.0 ft.	From 0.0 ft. to 15 ft.	
What is the nearest source of possible contamination:	
1 Septic tank		6 Seepage pit		11 Fuel storage (Former)	16 Other (specify below)	
2 Sewer lines		7 Pit privy		12 Fertilizer storage	
3 Watertight sewer lines		8 Sewage lagoon		13 Insecticide storage	
4 Lateral lines		9 Feedyard		14 Abandoned water well	
5 Cess Pool		10 Livestock pens		15 Oil well/ Gas well	
Direction from well?		West		How many feet?	15	
<table border="1" style="width: 100%; border-collapse: collapse;"> <thead> <tr> <th style="width: 10%;">FROM</th> <th style="width: 10%;">TO</th> <th style="width: 10%;">CODE</th> <th colspan="3" style="width: 60%;">PLUGGING MATERIALS</th> </tr> </thead> <tbody> <tr><td>0.0</td><td>3.0</td><td></td><td colspan="3">Compacted soils</td></tr> <tr><td>3.0</td><td>15.0</td><td></td><td colspan="3">Bentonite chips</td></tr> <tr><td></td><td></td><td></td><td colspan="3"></td></tr> <tr><td></td><td></td><td></td><td colspan="3"></td></tr> <tr><td></td><td></td><td></td><td colspan="3"></td></tr> <tr><td></td><td></td><td></td><td colspan="3"></td></tr> <tr><td></td><td></td><td></td><td colspan="3"></td></tr> <tr><td></td><td></td><td></td><td colspan="3"></td></tr> </tbody> </table>						FROM	TO	CODE	PLUGGING MATERIALS			0.0	3.0		Compacted soils			3.0	15.0		Bentonite chips																																						
FROM	TO	CODE	PLUGGING MATERIALS	
0.0	3.0		Compacted soils	
3.0	15.0		Bentonite chips	
RECEIVED NOV 12 2004 BUREAU OF WATER	
7 CONTRACTOR'S OR LANDOWNER'S CERTIFICATION: This water well was plugged under my jurisdiction and was completed on (mo/day/yr) 10/27/04 and this record is true to the best of my knowledge and belief. Kansas Water Well Contractor's License No. 692 This Water Well Record was completed on (mo/day/yr) 11/10/04 under the business name of Quad State Services, Inc. by (signature) 	
INSTRUCTIONS: Please fill in blanks and circle the correct answers. Send three copies to Kansas Department of Health and Environment, Bureau of Water, 1000 S W Jackson St., Ste. 420, Topeka, Kansas 66620-0001. Telephone: 785-296-3565. Send one to Water Well Owner and retain one for your records.	