

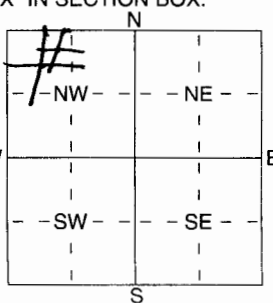
1 LOCATION OF WATER WELL:	Fraction	Section Number	Township Number	Range Number
County: <u>Butler</u>	<u>NE 1/4 NW 1/4 NW 1/4</u>	<u>14</u>	T <u>27</u> S	R <u>4</u> <u>E/W</u>

Distance and direction from nearest town or city street address of well if located within city?

Augusta

2 WATER WELL OWNER:	RR#, St. Address, Box #	City, State, ZIP Code	Board of Agriculture, Division of Water Resources Application Number:
<u>Larry Snodgrass</u>	<u>518 Stone Lake Dr</u>	<u>Augusta Kan 67010</u>	

3 LOCATE WELL'S LOCATION WITH AN "X" IN SECTION BOX:	4 DEPTH OF COMPLETED WELL	ft. ELEVATION:
--	---------------------------	----------------


WELL WATER TO BE USED AS: 5 Public water supply 8 Air conditioning 11 Injection well

1 Domestic 3 Feedlot 6 Oil field water supply 9 Dewatering 12 Other (Specify below)

2 Irrigation 4 Industrial 1 Domestic (lawn & garden) 10 Monitoring wellWas a chemical/bacteriological sample submitted to Department? Yes X No X; If yes, mo/day/yr sample was submitted Water Well Disinfected? Yes X No X

5 TYPE OF BLANK CASING USED:	5 Wrought iron	8 Concrete tile	CASING JOINTS: Glued <u>X</u> Clamped
------------------------------	----------------	-----------------	---------------------------------------

1 Steel 3 RMP (SR) 6 Asbestos-Cement 9 Other (specify below) Welded

2 PVC 4 ABS 7 Fiberglass Threaded


TYPE OF SCREEN OR PERFORATION MATERIAL:

1 Steel 3 Stainless Steel 5 Fiberglass 8 RMP (SR) 11 Other (Specify)

2 Brass 4 Galvanized Steel 6 Concrete tile 9 ABS 12 None used (open hole)

SCREEN OR PERFORATION OPENINGS ARE:

1 Continuous slot 3 Mill slot 5 Guazed wrapped 8 Saw cut 11 None (open hole)

2 Louvered shutter 4 Key punched 6 Wire wrapped 9 Drilled holes


6 GROUT MATERIAL:	1 Neat cement	2 Cement grout	<u>3</u> Bentonite	4 Other
-------------------	---------------	----------------	--------------------	---------


What is the nearest source of possible contamination:

1 Septic tank 4 Lateral lines 7 Pit privy 10 Livestock pens 14 Abandoned water well

2 Sewer lines 5 Cess pool 8 Sewage lagoon 11 Fuel storage 15 Oil well/Gas well

3 Watertight sewer lines 6 Seepage pit 9 Feedyard 12 Fertilizer storage 16 Other (specify below)Direction from well? 100 How many feet? 5

FROM	TO	LITHOLOGIC LOG	FROM	TO	PLUGGING INTERVALS
<u>0</u>	<u>4</u>	<u>Soil</u>			
<u>4</u>	<u>15</u>	<u>Rock</u>			
<u>15</u>	<u>28</u>	<u>Clay</u>			
<u>28</u>	<u>105</u>	<u>Shale & Lime</u>			

7 CONTRACTOR'S OR LANDOWNER'S CERTIFICATION: This water well was <u>1</u> constructed, (2) reconstructed, or (3) plugged under my jurisdiction and was completed on (mo/day/year) <u>12/4/05</u> and this record is true to the best of my knowledge and belief. Kansas Water Well Contractor's Licence No. <u>251</u> This Water Well Record was completed on (mo/day/yr) <u>12/30/05</u> under the business name of <u>Winter Well Drilling</u> by (signature) <u>Charles Winter</u>
--