

MWH 14

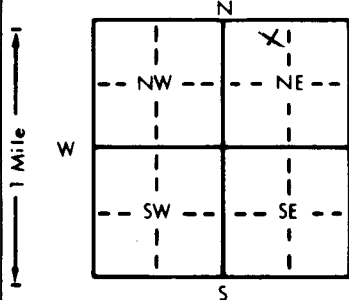
1 LOCATION OF WATER WELL:	Fraction	Section Number	Township Number	Range Number
County: <u>Butler</u>	<u>NE 1/4 NW 1/4 NE 1/4</u>	<u>27</u>	T <u>27</u> S	R <u>4</u> EW

Distance and direction from nearest town or city street address of well if located within city?

645 State St

2 WATER WELL OWNER:	RR#, St. Address, Box #	City, State, ZIP Code	Board of Agriculture, Division of Water Resources
<u>Town & Country markets</u>	<u>P.O. Box 17084</u>	<u>Wichita, Kansas 67217</u>	Application Number:

3 LOCATE WELL'S LOCATION WITH AN "X" IN SECTION BOX:	4 DEPTH OF COMPLETED WELL: <u>18</u> ft. ELEVATION:
--	---

Depth(s) Groundwater Encountered 1. 8 ft. 2. ft. 3. ft.

WELL'S STATIC WATER LEVEL ft. below land surface measured on mo/day/yr

Pump test data: Well water was ft. after hours pumping gpm

Est. Yield gpm: Well water was ft. after hours pumping gpm

Bore Hole Diameter 7 1/4 in. to 18 ft., and in. to ft.

WELL WATER TO BE USED AS:

1 Domestic 3 Feedlot 6 Oil field water supply 9 Dewatering 12 Other (Specify below)

2 Irrigation 4 Industrial 7 Lawn and garden only ☒ Monitoring well

Was a chemical/bacteriological sample submitted to Department? Yes No; If yes, mo/day/yr sample was submitted

Water Well Disinfected? Yes No

5 TYPE OF BLANK CASING USED:	5 Wrought iron	8 Concrete tile	CASING JOINTS: Glued Clamped
1 Steel	3 RMP (SR)	6 Asbestos-Cement	9 Other (specify below)
<input checked="" type="checkbox"/> PVC	4 ABS	7 Fiberglass	Welded
Blank casing diameter <u>2</u> in. to <u>3</u> ft., Dia			Threaded <input checked="" type="checkbox"/>

Casing height above land surface 0 in., weight Sched 40 lbs./ft. Wall thickness or gauge No.

TYPE OF SCREEN OR PERFORATION MATERIAL:	<input checked="" type="checkbox"/> PVC	10 Asbestos-cement
1 Steel	3 Stainless steel	5 Fiberglass
2 Brass	4 Galvanized steel	6 Concrete tile
		9 ABS
		11 Other (specify)
		12 None used (open hole)

SCREEN OR PERFORATION OPENINGS ARE:	5 Gauzed wrapped	8 Saw cut	11 None (open hole)
1 Continuous slot	<input checked="" type="checkbox"/> Mill slot	6 Wire wrapped	9 Drilled holes
2 Louvered shutter	4 Key punched	7 Torch cut	10 Other (specify)

SCREEN-PERFORATED INTERVALS:	From <u>18</u> ft. to <u>3</u> ft., From ft. to ft.
	From ft. to ft., From ft. to ft.

GRAVEL PACK INTERVALS:	From <u>18</u> ft. to <u>2.5</u> ft., From ft. to ft.
	From ft. to ft., From ft. to ft.

6 GROUT MATERIAL:	1 Neat cement	<input checked="" type="checkbox"/> Cement grout	<input checked="" type="checkbox"/> Bentonite	4 Other
Grout Intervals:	From ft. to ft., From ft. to ft.			

What is the nearest source of possible contamination:	10 Livestock pens	14 Abandoned water well
1 Septic tank	4 Lateral lines	7 Pit privy
2 Sewer lines	5 Cess pool	8 Sewage lagoon
3 Watertight sewer lines	6 Seepage pit	9 Feedyard
		11 Fuel storage
		12 Fertilizer storage
		13 Insecticide storage
		16 Other (specify below)

Direction from well?	How many feet?
----------------------	----------------

FROM	TO	LITHOLOGIC LOG	FROM	TO	PLUGGING INTERVALS
------	----	----------------	------	----	--------------------

0	5	Top Soil			
---	---	----------	--	--	--

5	10	Density clay Moist at 8.5			
---	----	---------------------------	--	--	--

10	15	Blw to tan Silty clay			
----	----	-----------------------	--	--	--

15	18	Tan Silty clay			
----	----	----------------	--	--	--

		W 17 at 17.0			
--	--	--------------	--	--	--

--	--	--	--	--	--

--	--	--	--	--	--

