

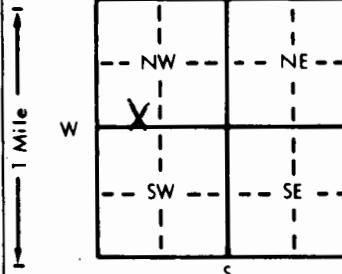
B-8.

WATER WELL RECORD

Form WWC-5

KSA 82a-1212

(COPK) 9-8-81

1 LOCATION OF WATER WELL:		Fraction SE $\frac{1}{4}$ SW $\frac{1}{4}$ NW $\frac{1}{4}$	Section Number 27	Township Number T 27 S	Range Number R 4 E		
Distance and direction from nearest town or city street address of well if located within city? mobil Oil Refinery, Second + Oak Streets, Augusta, Kansas							
2 WATER WELL OWNER:		mobil oil corporation					
RR#, St. Address, Box #:		P.O. Box 640					
City, State, ZIP Code:		Augusta, KS 67010					
3 LOCATE WELL'S LOCATION WITH AN "X" IN SECTION BOX:							
		4 DEPTH OF COMPLETED WELL... 28 ft. ELEVATION: 1216.6 Depth(s) Groundwater Encountered 21 ft. 2. ft. 3. ft. WELL'S STATIC WATER LEVEL 6.7 ft. below land surface measured on mo/day/yr Pump test data: Well water was ft. after hours pumping gpm Est. Yield gpm: Well water was ft. after hours pumping gpm Bore Hole Diameter 4.12 in. to 25.5 ft. and 3.314 in. to 28 ft. WELL WATER TO BE USED AS: 1 Domestic 3 Feedlot 5 Public water supply 8 Air conditioning 2 Irrigation 4 Industrial 6 Oil field water supply 9 Dewatering 7 Lawn and garden only 10 Observation well Was a chemical/bacteriological sample submitted to Department? Yes.....No..... If yes, mo/day/yr sample was submitted Water Well Disinfected? Yes No					
5 TYPE OF BLANK CASING USED:							
1 Steel 2 PVC		3 RMP (SR) 4 ABS		5 Wrought iron 6 Asbestos-Cement 7 Fiberglass			
Blank casing diameter 2 in. to ft.		ft., Dia. in. to ft., Dia.		in. to ft.			
Casing height above land surface 26 in., weight 6" steel Casing lbs./ft. Wall thickness or gauge No.							
TYPE OF SCREEN OR PERFORATION MATERIAL:							
1 Steel 2 Brass		3 Stainless steel 4 Galvanized steel		5 Fiberglass 6 Concrete tile 7 PVC			
8 RMP (SR) 9 ABS		8 Saw cut 9 Drilled holes 10 Other (specify)		10 Asbestos-cement 11 Other (specify) 12 None used (open hole)			
SCREEN OR PERFORATION OPENINGS ARE:							
1 Continuous slot 2 Louvered shutter		3 Mill slot 4 Key punched		5 Gauzed wrapped 6 Wire wrapped 7 Torch cut			
SCREEN-PERFORATED INTERVALS: From 21 ft. to 26 ft.		From 26 ft. to 28 ft.		ft. From ft. to ft.			
GRAVEL PACK INTERVALS: From 17 ft. to 28 ft.		From 28 ft. to ft.		ft. From ft. to ft.			
6 GROUT MATERIAL: 1 Neat cement 2 Cement grout 3 Bentonite 4 Other Cement/Bentonite mix							
Grout Intervals: From 0 ft. to 17 ft. From ft. to ft., From ft. to ft., From ft. to ft.							
What is the nearest source of possible contamination:							
1 Septic tank 2 Sewer lines 3 Watertight sewer lines		4 Lateral lines 5 Cess pool 6 Seepage pit		7 Pit privy 8 Sewage lagoon 9 Feedyard			
10 Livestock pens 11 Fuel storage 12 Fertilizer storage 13 Insecticide storage		14 Abandoned water well 15 Oil well/Gas well 16 Other (specify below)					
Direction from well? NORTHEAST How many feet? 200							
FROM	TO	LITHOLOGIC LOG		FROM	TO	LITHOLOGIC LOG	
21	21	Black to Brown Silty clay					
21	24	Light brown Fine to Med Silty, Gravelly sand					
24	28	Gray, Fossiliferous, cherty Limestone					
7 CONTRACTOR'S OR LANDOWNER'S CERTIFICATION: This water well was (1) constructed, (2) reconstructed, or (3) plugged under my jurisdiction and was completed on (mo/day/year) 7-31-81 and this record is true to the best of my knowledge and belief. Kansas Water Well Contractor's License No. 102 This Water Well Record was completed on (mo/day/yr) 8-26-81 under the business name of Layne-Western Company, Inc. by (signature) <u>Donald Y. Bennington</u>							
INSTRUCTIONS: Use typewriter or ball point pen, PLEASE PRESS FIRMLY and PRINT clearly. Please fill in blanks, underline or circle the correct answers. Send top three copies to Kansas Department of Health and Environment, Division of Environment, Environmental Geology Section, Topeka, KS 66620. Send one to WATER WELL OWNER and retain one for your records.							