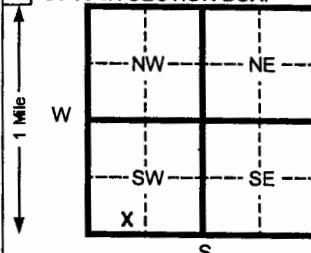


1 LOCATION OF WATER WELL:			Fraction	Section Number	Township Number	Range Number
County:	Butler	SE $\frac{1}{4}$ SW $\frac{1}{4}$ SW $\frac{1}{4}$	22	T 27 S	R 04	E
Distance and direction from nearest town or city street address of well if located within city? 610 W. 7th Ave., Augusta						
2 WATER WELL OWNER: Coastal Mart Inc.						
RR#, St. Address, Box # : 2 N. Nevada			Board of Agriculture, Division of Water Resources			
City, State, ZIP Code : Colorado Springs, CO 80903			Application Number:			
3 LOCATE WELL'S LOCATON WITH AN "X" IN SECTION BOX:						
		4 DEPTH OF COMPLETED WELL 24.6 ft. ELEVATION: 1224.30 (TOC) Depth(s) Groundwater Encountered 1 ft. 2 ft. 3 ft. WELL'S STATIC WATER LEVEL 16.89 ft. below land surface measured on mo/day/yr Pump test data: Well water was ft. after hours pumping gpm Est. Yield gpm: Well water was ft. after hours pumping gpm Bore Hole Diameter 8 in. to 25 ft. and in. to ft. WELL WATER TO BE USED AS: 5 Public water supply 8 Air conditioning 11 Injection well 1 Domestic 3 Feed lot 6 Oil field water supply 9 Dewatering 12 Other (Specify below) 2 Irrigation 4 Industrial 7 Lawn and garden (domestic) 10 Monitoring well				
Was a chemical/bacteriological sample submitted to Department? Yes No X If yes, mo/day/yr sample was submitted Water Well Disinfected? Yes No X						
5 TYPE OF BLANK CASING USED:						
1 Steel		3 RMP (SR)		5 Wrought Iron	8 Concrete tile	CASING JOINTS: Glued _____ Clamped _____
2 PVC		4 ABS		6 Asbestos-Cement	9 Other (specify below)	Welded
Blank casing diameter 2 in. to 24.6 ft., Dia		7 Fiberglass		Threaded Flush		
Casing height above land surface Flush in., weight 0.703				in. to ft., Dia	in. to ft.	ft.
lbs./ft. Wall thickness or gauge No. SCH. 40						
TYPE OF SCREEN OR PERFORATION MATERIAL:						
1 Steel		3 Stainless steel		5 Fiberglass	7 PVC	10 Asbestos-cement
2 Brass		4 Galvanized steel		6 Concrete tile	8 RMP (SR)	11 Other (specify)
SCREEN OR PERFORATION OPENINGS ARE:						
1 Continuous slot		3 Mill slot		5 Gauzed wrapped	8 Saw cut	11 None (open hole)
2 Louvered shutter		4 Key punched		6 Wire wrapped	9 Drilled holes	
				7 Torch cut	10 Other (specify)	
SCREEN-PERFORATED INTERVALS: From 14.6 ft. to 24.6 ft. From ft. to ft. From ft. to ft.						
GRAVEL PACK INTERVALS: From 13 ft. to 25 ft. From ft. to ft. From ft. to ft.						
6 GROUT MATERIAL: 1 Neat cement 2 Cement grout 3 Bentonite 4 Other						
Grout Intervals From 2 ft. to 13 ft. From				ft. to ft. From	ft. to ft. From	ft. to ft.
What is the nearest source of possible contamination:						
1 Septic tank		4 Lateral lines		7 Pit privy	10 Livestock pens	14 Abandoned water well
2 Sewer lines		5 Cess pool		8 Sewage lagoon	11 Fuel storage	15 Oil well/ Gas well
3 Watertight sewer lines		6 Seepage pit		9 Feedyard	12 Fertilizer storage	16 Other (specify below)
Direction from well? How many feet?						
FROM	TO	CODE	LITHOLOGIC LOG	FROM	TO	PLUGGING INTERVALS
0	1		Cement			
1	5		Sandy Fat Clay			
5	10		Silty Fat Clay			
10	15		Lean Clay			
15	20		Silty Lean Clay			
20	25		Silty Lean Clay to Sand			
7 CONTRACTOR'S OR LANDOWNER'S CERTIFICATION: This water well was (1) constructed, (2) reconstructed, or (3) plugged under my jurisdiction and was completed on (mo/day/yr) 10/31/06 and this record is true to the best of my knowledge and belief. Kansas Water Well Contractor's License No. 531 This Water Well Record was completed on (mo/day/yr) 12/1/06 under the business name of Geotechnical Services Inc. by (signature) Sarah A. W.						
INSTRUCTIONS: Please fill in blanks and circle the correct answers. Send three copies to Kansas Department of Health and Environment, Bureau of Water, 1000 S W Jackson St, Ste. 420, Topeka, Kansas 66612-1367. Telephone: 913-296-5545. Send one to WATER WELL OWNER and retain one for your records.						