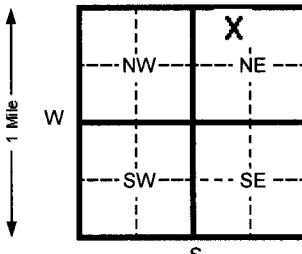


1 LOCATION OF WATER WELL:		Fraction County: Butler NE $\frac{1}{4}$ NW $\frac{1}{4}$ NE $\frac{1}{4}$		Section Number 27	Township Number T 27 S	Range Number R 4 W
Distance and direction from nearest town or city street address of well if located within city? 127 East 7th Street, Augusta, Kansas, Lat.: N 37° 40' 43.54" Long.: W 96° 58' 38.96"						
-2 WATER WELL OWNER: Phillips 66 Company RR#, St. Address, Box # : 1366 Phillips 66 Bldg. Board of Agriculture, Division of Water Resources City, State, ZIP Code : Bartlesville, OK 74004 Application Number:						
3 LOCATE WELL'S LOCATON WITH AN "X" IN SECTION BOX:		4 DEPTH OF COMPLETED WELL Depth(s) Groundwater Encountered 1 Unknown ft. 2 ft. 3 ft. WELL'S STATIC WATER LEVEL 7.43 ft. below land surface measured on mo/day/yr 10/27/08 Pump test data: Well water was N/A ft. after hours pumping gpm Est. Yield N/A gpm: Well water was N/A ft. after hours pumping gpm Bore Hole Diameter 8 in. to 20 ft. and in. to ft. WELL WATER TO BE USED AS: 5 Public water supply 8 Air conditioning 11 Injection well 1 Domestic 3 Feed lot 6 Oil field water supply 9 Dewatering 12 Other (Specify below) 2 Irrigation 4 Industrial 7 Lawn and garden (domestic) 10 Monitoring well				
		Was a chemical/bacteriological sample submitted to Department? Yes No X If yes, mo/day/yr sample was submitted Water Well Disinfected? Yes No X				
5 TYPE OF BLANK CASING USED: 1 Steel 3 RMP (SR) 5 Wrought Iron 8 Concrete tile CASING JOINTS: Glued Clamped 2 PVC 4 ABS 6 Asbestos-Cement 9 Other (specify below) Welded Blank casing diameter 2 in. to 5 ft., Dia in. to ft., Dia in. to ft. Casing height above land surface 0 in., weight 0.682 lbs./ft. Wall thickness or gauge No. 0.1875 in.						
6 TYPE OF SCREEN OR PERFORATION MATERIAL: 1 Steel 3 Stainless steel 5 Fiberglass 7 PVC 10 Asbestos-cement 2 Brass 4 Galvanized steel 6 Concrete tile 8 RMP (SR) 11 Other (specify) SCREEN OR PERFORATION OPENINGS ARE: 1 Continuous slot 3 Mill slot 6 Wire wrapped 8 Saw cut 11 None (open hole) 2 Louvered shutter 4 Key punched 7 Torch cut 9 Drilled holes 10 Other (specify)						
SCREEN-PERFORATED INTERVALS: From 5 ft. to 20 ft. From ft. to ft. From ft. to ft. From ft. to ft. GRAVEL PACK INTERVALS: From 3 ft. to 20 ft. From ft. to ft. From ft. to ft. From ft. to ft.						
6 GROUT MATERIAL: 1 Neat cement 2 Cement grout 3 Bentonite 4 Other Grout Intervals From 1 ft. to 3 ft. From ft. to ft. From ft. to ft. What is the nearest source of possible contamination: 1 Septic tank 4 Lateral lines 7 Pit privy 10 Livestock pens 14 Abandoned water well 2 Sewer lines 5 Cess pool 8 Sewage lagoon 11 Fuel storage 15 Oil well/ Gas well 3 Watertight sewer lines 6 Seepage pit 9 Feedyard 12 Fertilizer storage 16 Other (specify below) 13 Insecticide storage						
Direction from well? Unknown How many feet? Unknown						
FROM	TO	CODE	LITHOLOGIC LOG	FROM	TO	PLUGGING INTERVALS
0	0.67	--	Concrete			
.67	1	11	Gravel base			
1	20	03	Brown, silty clay			
7 CONTRACTOR'S OR LANDOWNER'S CERTIFICATION: This water well was (1) constructed, (2) reconstructed, or (3) plugged under my jurisdiction and was completed on (mo/day/yr) 10/7/08 and this record is true to the best of my knowledge and belief. Kansas Water Well Contractor's License No. 616 This Water Well Record was completed on (mo/day/yr) 11/12/08 under the business name of Thiele Geotech, Inc. by (signature) D-JA						
INSTRUCTIONS: Please fill in blanks and circle the correct answers. Send three copies to Kansas Department of Health and Environment, Bureau of Water, 1000 S W Jackson St., Ste. 420, Topeka, Kansas 66612-1367. Telephone: 913-296-5545. Send one to WATER WELL OWNER and retain one for your records.						

OFFICE USE ONLY

R

SEC