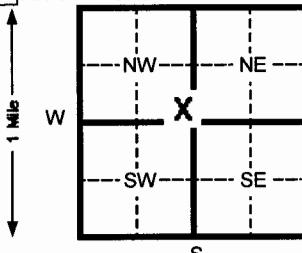


1 LOCATION OF WATER WELL:			Fraction Butler	SE $\frac{1}{4}$ SE $\frac{1}{4}$ NW $\frac{1}{4}$	Section Number 27	Township Number 27	Range Number R 4	EW
Distance and direction from nearest town or city street address of well if located within city: The well is located approximately 77 feet south and 120 feet west of W 3rd Ave and Walnut Street in Augusta. Latitude N37° 40' 25.09" Longitude W96° 58' 51.01"								
2 WATER WELL OWNER: Williams Petroleum Services, LLC								
RR#, St. Address, Box #			PO Box 3483			Board of Agriculture, Division of Water Resources		
City, State, ZIP Code			Tulsa, Oklahoma 74101-3483			Application Number: Not Applicable		
3 LOCATE WELL'S LOCATON WITH AN "X" IN SECTION BOX:			4 DEPTH OF COMPLETED WELL 32 ft. ELEVATION:					
			Depth(s) Groundwater Encountered 1 10 ft. 2 ft. 3 ft. WELL'S STATIC WATER LEVEL 6.42 ft. below land surface measured on mo/day/yr 9/4/08 Pump test data: Well water was ft. after hours pumping gpm Est. Yield gpm: Well water was ft. after hours pumping gpm Bore Hole Diameter 8 in. to 32 ft. and in. to ft. WELL WATER TO BE USED AS: 5 Public water supply 8 Air conditioning 11 Injection well 1 Domestic 3 Feed lot 6 Oil field water supply 9 Dewatering 12 Other (Specify below) 2 Irrigation 4 Industrial 7 Lawn and garden (domestic) 10 Monitoring well					
Was a chemical/bacteriological sample submitted to Department? Yes <input checked="" type="checkbox"/> No <input type="checkbox"/> If yes, mo/day/yr sample was submitted								
Water Well Disinfected? Yes <input type="checkbox"/> No <input checked="" type="checkbox"/>								
5 TYPE OF BLANK CASING USED:								
1 Steel <input checked="" type="checkbox"/> 2 PVC			3 RMP (SR) <input type="checkbox"/> 4 ABS			5 Wrought Iron <input type="checkbox"/> 6 Asbestos-Cement <input type="checkbox"/> 7 Fiberglass		
Blank casing diameter 2 in. to 32 ft., Dia			in. to 0.682 ft., Dia			in. to ft.		
Casing height above land surface 0 in., weight						lbs./ft. Wall thickness or gauge No. 0.1875 in.		
TYPE OF SCREEN OR PERFORATION MATERIAL:								
1 Steel 2 Brass			3 Stainless steel 4 Galvanized steel			5 Fiberglass 6 Concrete tile		
SCREEN OR PERFORATION OPENINGS ARE:								
1 Continuous slot 2 Louvered shutter			<input checked="" type="checkbox"/> 3 Mill slot <input type="checkbox"/> 4 Key punched			5 Gauzed wrapped 6 Wire wrapped 7 Torch cut		
SCREEN-PERFORATED INTERVALS: From 27 ft. to 32 ft. From ft. to ft.								
GRAVEL PACK INTERVALS: From 25 ft. to 32 ft. From ft. to ft.								
6 GROUT MATERIAL: 1 Neat cement 2 Cement grout 3 Bentonite 4 Other								
Grout Intervals From 0 ft. to 25 ft. From ft. to ft. From ft. to ft.								
What is the nearest source of possible contamination:								
1 Septic tank <input checked="" type="checkbox"/> 2 Sewer lines 3 Watertight sewer lines			4 Lateral lines <input type="checkbox"/> 5 Cess pool <input type="checkbox"/> 6 Seepage pit			7 Pit privy <input type="checkbox"/> 8 Sewage lagoon <input type="checkbox"/> 9 Feedyard		
10 Livestock pens 11 Fuel storage 12 Fertilizer storage 13 Insecticide storage								
14 Abandoned water well 15 Oil well/ Gas well 16 Other (specify below)								
Direction from well? W How many feet? approximately 450								
7 CONTRACTOR'S OR LANDOWNER'S CERTIFICATION: This water well was (1) constructed, (2) reconstructed, or (3) plugged under my jurisdiction and was completed on (mo/day/yr) 8/13/08 and this record is true to the best of my knowledge and belief. Kansas Water Well Contractor's License No. 616 This Water Well Record was completed on (mo/day/yr) 3/18/09 under the business name of Thiele Geotech, Inc. by (signature) 								
INSTRUCTIONS: Please fill in blanks and circle the correct answers. Send three copies to Kansas Department of Health and Environment, Bureau of Water, Topeka, Kansas 66620-0001. Telephone: 913-296-5545. Send one to WATER WELL OWNER and retain one for your records.								

OFFICE USE ONLY

SEC