

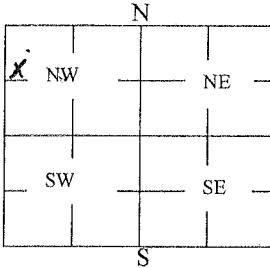
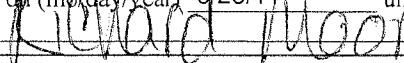
Constructed 4@280

WATER WELL PLUGGING RECORD

Form WWC-5P

KSA 82a-1212

ID NO. _____

1 LOCATION OF WATER WELL: County: BUTLER		Fraction SW 1/4 NW 1/4 NW 1/4 1/4	Section Number 18	Township Number T 27 S	Range Number 4 <input checked="" type="checkbox"/> E <input type="checkbox"/> W	
Street/Rural Address of Well Location; if unknown, distance & direction from nearest town or intersection: If at owner's address, check here <input type="checkbox"/>		Global Positioning Systems (GPS) information: Latitude: 37.7050 (in decimal degrees) Longitude: -97.0429 (in decimal degrees) Elevation: Datum: <input type="checkbox"/> WGS84, <input type="checkbox"/> NAD83, <input type="checkbox"/> NAD27 Collection Method: <input checked="" type="checkbox"/> GPS unit (Make/Model): MAGELLAN <input type="checkbox"/> Digital Map/Photo, <input type="checkbox"/> Topographic Map, <input type="checkbox"/> Land Survey Est. Accuracy: <input type="checkbox"/> < 3 m, <input type="checkbox"/> 3-5 m, <input type="checkbox"/> 5-15 m, <input type="checkbox"/> > 15 m	
2 WATER WELL OWNER: PAT HERIAN RR#, St. Address, Box #: 8241 SW HILLCREEK City, State ZIP Code: AUGUSTA, KS	
3 MARK WELL'S LOCATION WITH AN "X" IN SECTION BOX:		4 DEPTH OF WELL 280 ft. WELL'S STATIC WATER LEVEL N/A ft WELL WAS USED AS:	
		<input type="checkbox"/> Domestic <input type="checkbox"/> Irrigation <input type="checkbox"/> Feedlot <input type="checkbox"/> Industrial	<input type="checkbox"/> Public Water Supply <input type="checkbox"/> Oil Field Water Supply <input type="checkbox"/> Domestic (Lawn & Garden) <input type="checkbox"/> Air Conditioning	<input type="checkbox"/> Dewatering <input type="checkbox"/> Monitoring <input checked="" type="checkbox"/> Injection Well <input checked="" type="checkbox"/> Other Geothermal	
Was a chemical/bacteriological sample submitted to Department? Yes <input type="checkbox"/> No <input checked="" type="checkbox"/>	
5 TYPE OF BLANK CASING USED:	
<input type="checkbox"/> Steel <input type="checkbox"/> RMP (SR) <input type="checkbox"/> PVC <input type="checkbox"/> ABS <input type="checkbox"/> Wrought <input type="checkbox"/> Asbestos-Cement <input type="checkbox"/> Fiberglass <input type="checkbox"/> Concrete Tile <input checked="" type="checkbox"/> Other (Specify below) N/A	
Blank casing diameter _____ in. Was casing pulled? Yes <input type="checkbox"/> No <input type="checkbox"/> If yes, how much _____ Casing height above or below land surface _____ in.	
6 GROUT PLUG MATERIAL: <input type="checkbox"/> Neat cement <input type="checkbox"/> Cement grout <input checked="" type="checkbox"/> Bentonite <input type="checkbox"/> Other _____	
Grout Plug Intervals: From _____ ft. to _____ ft., From _____ ft. to _____ ft., From _____ to _____ ft.	
What is the nearest source of possible contamination:	
<input type="checkbox"/> Septic tank <input type="checkbox"/> Sewer lines <input type="checkbox"/> Watertight sewer lines <input type="checkbox"/> Lateral lines <input type="checkbox"/> Cess pool		<input type="checkbox"/> Seepage pit <input type="checkbox"/> Pit privy <input type="checkbox"/> Sewage lagoon <input type="checkbox"/> Feedyard <input type="checkbox"/> Livestock pens	<input type="checkbox"/> Fuel Storage <input type="checkbox"/> Fertilizer storage <input type="checkbox"/> Insecticide storage <input type="checkbox"/> Abandoned water well <input type="checkbox"/> Oil well/Gas well	<input checked="" type="checkbox"/> Other (specify below) HOUSE Direction from well? SW How many feet? 21	
<table border="1"> <thead> <tr> <th>FROM</th> <th>TO</th> <th>PLUGGING MATERIALS</th> <th>FROM</th> <th>TO</th> <th>PLUGGING MATERIALS</th> </tr> </thead> <tbody> <tr> <td>0</td> <td>10</td> <td>BROWN CLAY</td> <td></td> <td></td> <td></td> </tr> <tr> <td>10</td> <td>40</td> <td>YELLOW CLAY</td> <td></td> <td></td> <td></td> </tr> <tr> <td>40</td> <td>130</td> <td>BLUE SHALE</td> <td></td> <td></td> <td></td> </tr> <tr> <td>130</td> <td>150</td> <td>RED CLAY</td> <td></td> <td></td> <td></td> </tr> <tr> <td>150</td> <td>280</td> <td>GRAY SHALE</td> <td></td> <td></td> <td></td> </tr> <tr> <td></td> <td></td> <td></td> <td></td> <td></td> <td></td> </tr> <tr> <td></td> <td></td> <td></td> <td></td> <td></td> <td></td> </tr>
7 CONTRACTOR'S OR LANDOWNER'S CERTIFICATION: This water well was plugged under my jurisdiction and was completed on (mo/day/yea) 7/25/11 and this record is true to the best of my knowledge and belief. Kansas Water Well Contractor's License No. 812. This Water Well Record was completed on (mo/day/year) 8/23/11 under the business name of Environmental Loop Service, Inc by (signature) 	
INSTRUCTIONS: Use typewriter or ballpoint pen. Please press firmly and print clearly. Please fill in blanks, underline or circle the correct answers. Send top three copies to Kansas Department of Health and Environment, Bureau of Water, Geology Section, 1000 SW Jackson St., Ste. 420, Topeka, Kansas 66612-1367. Telephone: 785/296-5524. Send one to Water Well Owner and retain one for your records. Visit us at http://www.kdheks.gov/waterwell/index.html .	
Check one: <input checked="" type="checkbox"/> White Copy <input type="checkbox"/> Blue Copy <input type="checkbox"/> Pink Copy	