

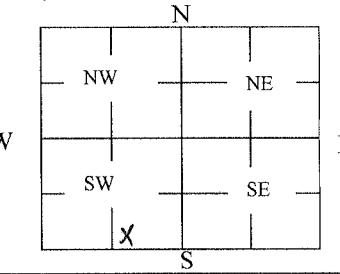
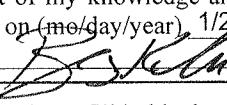
## WATER WELL PLUGGING RECORD

Form WWC-5P

KSA 82a-1212

ID NO.

MW-3

1 LOCATION OF WATER WELL:		Fraction County: Butler SE 1/4 SW 1/4 SE 1/4 SW 1/4	Section Number 22	Township Number T 27 S	Range Number 4 <input checked="" type="checkbox"/> E <input type="checkbox"/> W	
Street/Rural Address of Well Location; if unknown, distance & direction from nearest town or intersection: If at owner's address, check here <input type="checkbox"/> 520 W. 7TH ST., AUGUSTA, KS			<b>Global Positioning Systems (GPS) information:</b> Latitude: 37.67964 (in decimal degrees) Longitude: 96.98421 (in decimal degrees) Elevation: 1222.21 Datum: <input type="checkbox"/> WGS84, <input type="checkbox"/> NAD83, <input type="checkbox"/> NAD27 Collection Method:	
2 WATER WELL OWNER:		McDonald's Corporation RR#, St. Address, Box #: 11880 College Blvd. City, State ZIP Code: Overland Park, KS 66210	
3 MARK WELL'S LOCATION WITH AN "X" IN SECTION BOX:		4 DEPTH OF WELL 20.9 ft. WELL'S STATIC WATER LEVEL 13.86 ft WELL WAS USED AS:	
		<input type="checkbox"/> Domestic <input type="checkbox"/> Irrigation <input type="checkbox"/> Feedlot <input type="checkbox"/> Industrial <input type="checkbox"/> Public Water Supply <input type="checkbox"/> Oil Field Water Supply <input type="checkbox"/> Domestic (Lawn & Garden) <input type="checkbox"/> Air Conditioning <input checked="" type="checkbox"/> Dewatering <input checked="" type="checkbox"/> Monitoring <input type="checkbox"/> Injection Well <input type="checkbox"/> Other	
Was a chemical/bacteriological sample submitted to Department? Yes <input type="checkbox"/> No <input checked="" type="checkbox"/>	
5 TYPE OF BLANK CASING USED:	
<input type="checkbox"/> Steel <input type="checkbox"/> RMP (SR) <input type="checkbox"/> Wrought <input type="checkbox"/> Fiberglass <input checked="" type="checkbox"/> PVC <input type="checkbox"/> ABS <input type="checkbox"/> Asbestos-Cement <input type="checkbox"/> Concrete Tile <input type="checkbox"/> Other (Specify below)	
Blank casing diameter 2 in. Was casing pulled? Yes <input type="checkbox"/> No <input checked="" type="checkbox"/> If yes, how much _____ Casing height above or below land surface _____ in.	
6 GROUT PLUG MATERIAL:	
Grout Plug Intervals: From 0.5 ft. to 20.9 ft., From _____ ft. to _____ ft., From _____ to _____ ft.	
What is the nearest source of possible contamination:	
<input type="checkbox"/> Septic tank <input type="checkbox"/> Sewer lines <input type="checkbox"/> Watertight sewer lines <input type="checkbox"/> Lateral lines <input type="checkbox"/> Cess pool		<input type="checkbox"/> Seepage pit <input type="checkbox"/> Pit privy <input type="checkbox"/> Sewage lagoon <input type="checkbox"/> Feedyard <input type="checkbox"/> Livestock pens		<input checked="" type="checkbox"/> Fuel Storage <input type="checkbox"/> Fertilizer storage <input type="checkbox"/> Insecticide storage <input type="checkbox"/> Abandoned water well <input type="checkbox"/> Oil well/Gas well <input type="checkbox"/> Other (specify below) Direction from well? EAST How many feet? 50	
<table border="1"> <thead> <tr> <th>FROM</th> <th>TO</th> <th>PLUGGING MATERIALS</th> <th>FROM</th> <th>TO</th> <th>PLUGGING MATERIALS</th> </tr> </thead> <tbody> <tr> <td>0</td> <td>0.5</td> <td>ASPHALT</td> <td></td> <td></td> <td></td> </tr> <tr> <td>0.5</td> <td>20.9</td> <td>BENTONITE</td> <td></td> <td></td> <td></td> </tr> <tr> <td></td> <td></td> <td></td> <td></td> <td></td> <td></td> </tr> </tbody> </table>						FROM	TO	PLUGGING MATERIALS	FROM	TO	PLUGGING MATERIALS	0	0.5	ASPHALT				0.5	20.9	BENTONITE																																	
FROM	TO	PLUGGING MATERIALS	FROM	TO	PLUGGING MATERIALS	
0	0.5	ASPHALT	
0.5	20.9	BENTONITE	
7 CONTRACTOR'S OR LANDOWNER'S CERTIFICATION: This water well was plugged under my jurisdiction and was completed on (mo/day/year) 12/29/11 and this record is true to the best of my knowledge and belief. Kansas Water Well Contractor's License No. 416. This Water Well Record was completed on (mo/day/year) 1/23/12 under the business name of Terracon Consultants, Inc. by (signature) 	
<b>INSTRUCTIONS:</b> Use typewriter or ballpoint pen. Please press firmly and print clearly. Please fill in blanks, underline or circle the correct answers. Send top three copies to Kansas Department of Health and Environment, Bureau of Water, Geology Section, 1000 SW Jackson St., Ste. 420, Topeka, Kansas 66612-1367. Telephone: 785/296-5524. Send one to Water Well Owner and retain one for your records. Visit us at <a href="http://www.kdheks.gov/waterwell/index.html">http://www.kdheks.gov/waterwell/index.html</a> .	
Check one: <input checked="" type="checkbox"/> White Copy <input type="checkbox"/> Blue Copy <input type="checkbox"/> Pink Copy	