

1 LOCATION OF WATER WELL:	Fraction County: <b>Butler</b>	SW $\frac{1}{4}$ SE $\frac{1}{4}$ SW $\frac{1}{4}$	Section Number 22	Township Number T 27 S	Range Number R 4 E
---------------------------	-----------------------------------	--	----------------------	---------------------------	-----------------------

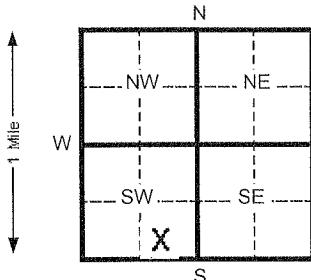
Distance and direction from nearest town or city street address of well if located within city?

520 W. 7<sup>th</sup> St., Augusta, KS2 WATER WELL OWNER: **KDHE-BER**RR#, St. Address, Box #: **1000 SW Jackson; Ste. 410**

Board of Agriculture, Division of Water Resources

City, State, ZIP Code: **Topeka, KS 66612**

Application Number:

3 LOCATE WELL'S LOCATON WITH  
AN "X" IN SECTION BOX:

## 4 DEPTH OF COMPLETED WELL

20 ft. ELEVATION: **1222.72**Depth(s) Groundwater Encountered 1.5 **15** ft. 2 ft. 3 ft. 4 ft.WELL'S STATIC WATER LEVEL **12.73** ft. below land surface measured on mo/day/yr **04/23/13**

Pump test data: Well water was Ft. after hours pumping Gpm

Est. Yield Gpm: Well water was Ft. after Hours pumping Gpm

Bore Hole Diameter **6.5** in. to **20** ft. and in. to Ft.

WELL WATER TO BE USED AS: 5 Public water supply 8 Air conditioning 11 Injection well

1 Domestic 3 Feed lot 6 Oil field water supply 9 Dewatering 12 Other (Specify below)

2 Irrigation 4 Industrial 7 Lawn and garden (domestic) 10 Monitoring well **MW-5R**Was a chemical/bacteriological sample submitted to Department? Yes **No X** If yes, mo/day/yr sample was Submitted Water Well Disinfected? Yes **No X**

## 5 TYPE OF BLANK CASING USED:

1 Steel 3 RMP (SR)  
2 PVC 4 ABS

5 Wrought Iron 8 Concrete tile Casing joints: Glued Clamped

6 Asbestos-Cement 9 Other (specify below) Welded  
7 FiberglassThreaded **X**Blank casing diameter **2** in. to **10** ft., Dia in. to ft., Dia in. to ft.Casing height above land surface **FLUSH** in., weight **SCH 40** Lbs./ft. Wall thickness or gauge No.

7 PVC 10 Asbestos-cement

TYPE OF SCREEN OR PERFORATION MATERIAL:

1 Steel 3 Stainless steel 5 Fiberglass 8 RMP (SR) 11 Other (specify)  
2 Brass 4 Galvanized steel 6 Concrete tile 9 ABS 12 None used (open hole)

SCREEN OR PERFORATION OPENINGS ARE: 5 Gauzed wrapped 8 Saw cut 11 None (open hole)

1 Continuous slot 3 Mill slot 6 Wire wrapped 9 Drilled holes  
2 Louvered shutter 4 Key punched 7 Torch cut 10 Other (specify)SCREEN-PERFORATED INTERVALS: From **10** ft. to **20** ft. From ft. to ft. From ft. to ft.SAND PACK INTERVALS: From **8** ft. to **20** ft. From ft. to ft. From ft. to ft.

From ft. to ft. From ft. to ft. From ft. to ft.

6 GROUT MATERIAL: 1 Neat cement 2 Cement grout 3 Bentonite 4 Other

Grout Intervals From **2** ft. to **6** ft. From **3** ft. to **6** ft. From **8** ft. to **ft.** ft. to **ft.**

What is the nearest source of possible contamination:

1 Septic tank 4 Lateral lines 7 Pit privy 10 Livestock pens 14 Abandoned water well  
2 Sewer lines 5 Cess pool 8 Sewage lagoon 11 Fuel storage 15 Oil well/ Gas well  
3 Watertight sewer lines 6 Seepage pit 9 Feedyard 12 Fertilizer storage 16 Other (specify below)**Contaminated Site**

Direction from well? How many feet?

FROM TO CODE LITHOLOGIC LOG FROM TO PLUGGING INTERVALS

**0** **0.5** **Asphalt****0.5** **20** **Silty Clay****20** **TD** **End of Borehole**

## 7 CONTRACTOR'S OR LANDOWNER'S CERTIFICATION: This water well was (x) constructed, (2) reconstructed, or (3) plugged under my jurisdiction and w

Completed on (mo/day/yr) **04/11/13** And this record is true to the best of my knowledge and belief. KansasWater Well Contractor's License No. **585** This Water Well Record was completed on (mo/day/yr) **05/11/13**under the business name of **Associated Environmental, Inc.** By (signature) **Bradley J. Johnson**

INSTRUCTIONS: Please fill in blanks and circle the correct answers. Send three copies to Kansas Department of Health and Environment, Bureau of Water, Topeka, Kansas 66620-0001. Telephone: 913-296-5545. Send one to WATER WELL OWNER and retain one for your records.