

MW-3

WATER WELL PLUGGING RECORD Form WWC-5P KSA 82a-1212 ID NO. []

1 LOCATION OF WATER WELL: Fraction Section Number Township Number Range Number
County: Butler 1/4 NE 1/4 NW 1/4 NE 1/4 27 T 27 S 4 [X] E [] W


Street/Rural Address of Well Location; if unknown, distance & direction from nearest town or intersection: If at owner's address, check here [] 645 North State Street; Augusta KS

Global Positioning Systems (GPS) information:
Latitude: 37.67987 (in decimal degrees)
Longitude: 96.97919 (in decimal degrees)
Elevation: _____
Datum: [X] WGS84, [] NAD83, [] NAD27
Collection Method:

2 WATER WELL OWNER: Bank of America
RR#, St. Address, Box #: 1100 North King St.
City, State ZIP Code: Wilmington DE 19884

[X] GPS unit (Make/Model: Garmin etrek 10)
[] Digital Map/Photo, [] Topographic Map, [] Land Survey
Est. Accuracy: [] < 3 m, [X] 3-5 m, [] 5-15 m, [] > 15 m

3 MARK WELL'S LOCATION WITH AN "X" IN SECTION BOX:

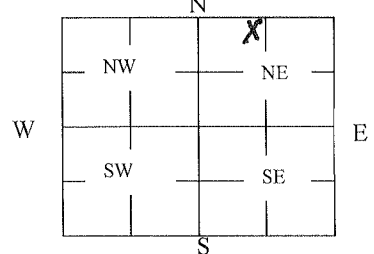

4 DEPTH OF WELL 18.5 ft.

WELL'S STATIC WATER LEVEL 9.90 ft

WELL WAS USED AS:

- [] Domestic [] Public Water Supply [] Dewatering
- [] Irrigation [] Oil Field Water Supply [X] Monitoring
- [] Feedlot [] Domestic (Lawn & Garden) [] Injection Well
- [] Industrial [] Air Conditioning [] Other _____

Was a chemical/bacteriological sample submitted to Department? Yes [] No [X]

5 TYPE OF BLANK CASING USED:

- [] Steel [] RMP (SR) [] Wrought [] Fiberglass [] Other (Specify below)
- [X] PVC [] ABS [] Asbestos-Cement [] Concrete Tile

Blank casing diameter 2 in. Was casing pulled? Yes [X] No [] If yes, how much _____
Casing height above or below land surface 3 in.

6 GROUT PLUG MATERIAL: [] Neat cement [] Cement grout [X] Bentonite [] Other _____

Grout Plug Intervals: From 18.5 ft. to 3 ft., From _____ ft. to _____ ft., From _____ to _____ ft.

What is the nearest source of possible contamination:

- [] Septic tank [] Seepage pit [] Fuel Storage [] Other (specify below)
- [] Sewer lines [] Pit privy [] Fertilizer storage
- [] Watertight sewer lines [] Sewage lagoon [] Insecticide storage
- [] Lateral lines [] Feedyard [] Abandoned water well Direction from well? _____
- [] Cess pool [] Livestock pens [] Oil well/Gas well How many feet? _____

FROM	TO	PLUGGING MATERIALS	FROM	TO	PLUGGING MATERIALS
18.5	3	Bentonite			
3	0	Concrete			

7 CONTRACTOR'S OR LANDOWNER'S CERTIFICATION: This water well was plugged under my jurisdiction and was completed on (mo/day/year) 6-26-14 and this record is true to the best of my knowledge and belief. Kansas Water Well Contractor's License No. 710. This Water Well Record was completed on (mo/day/year) 7-7-14 under the business name of Below Ground Surface, Inc. by (signature) []

INSTRUCTIONS: Use typewriter or ballpoint pen. Please press firmly and print clearly. Please fill in blanks, underline or circle the correct answers. Send one copy to Kansas Department of Health and Environment, Bureau of Water, Geology Section, 1000 SW Jackson St., Ste. 420, Topeka, Kansas 66612-1367. Telephone: 785/296-5524. Send one to Water Well Owner and retain one for your records. Visit us at http://www.kdheks.gov/waterwell/index.html.