

PA02-09

WATER WELL RECORD


Form WWC-5

Division of Water Resources App. No.

1 LOCATION OF WATER WELL: County: Butler Fraction NW 1/4 SE 1/4 NE 1/4 SW 1/4 Section Number 27 Township No. T 27 S Range Number R 4 [X]E []W

Street/Rural Address of Well Location; if unknown, distance & direction from nearest town or intersection: Former August Refinery; W. 2nd Ave., Augusta, KS Global Positioning System (GPS) information: Latitude: 37.668510 Longitude: 96.983265

2 WATER WELL OWNER: Williams Petroleum Services RR#, Street Address, Box #: One Williams Center City, State, ZIP Code : Tulsa, OK 74101

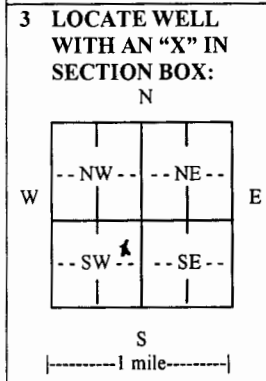

3 LOCATE WELL WITH AN 'X' IN SECTION BOX: N E W 4 DEPTH OF COMPLETED WELL 20 ft. Depth(s) Groundwater Encountered (1) 11.00 ft. (2) ft. (3) ft. WELL'S STATIC WATER LEVEL 11.00 ft. below land surface measured on mo/day/yr

5 TYPE OF CASING USED: [] Steel [X] PVC [] Other CASING JOINTS: [] Glued [] Clamped [] Welded [X] Threaded Casing diameter 2 in. to 10 ft., Diameter in. to ft., Diameter in. to ft. Casing height above land surface 30 in., Weight lbs./ft., Wall thickness or gauge No. Sch. 40

TYPE OF SCREEN OR PERFORATION MATERIAL: [] Steel [] Stainless Steel [X] PVC [] Other (Specify) [] Brass [] Galvanized Steel [] None used (open hole) SCREEN OR PERFORATION OPENINGS ARE: [] Continuous slot [X] Mill slot [] Gauze wrapped [] Torch cut [] Drilled holes [] None (open hole)

SCREEN-PERFORATED INTERVALS: From 20 ft. to 0 ft., From ft. to ft., From ft. to ft. GRAVEL PACK INTERVALS: From 20 ft. to 3 ft., From ft. to ft., From ft. to ft.

6 GROUT MATERIAL: [] Neat cement [] Cement grout [X] Bentonite [] Other Grout Intervals: From 3 ft. to 2 ft., From ft. to ft., From ft. to ft. What is the nearest source of possible contamination: [] Septic tank [] Lateral lines [] Pit privy [] Livestock pens [] Insecticide storage [] Other (specify below)

Table with columns: FROM, TO, LITHOLOGIC LOG, FROM, TO, LITHO. LOG (cont.) or PLUGGING INTERVALS. Row 1: FROM 0 TO 20 Silty Clay

7 CONTRACTOR'S OR LANDOWNER'S CERTIFICATION: This water well was [X] constructed [] reconstructed, or [] plugged under my jurisdiction and was completed on (mo/day/year) 5/9/14 and this record is true to the best of my knowledge and belief. Kansas Water Well Contractor's License No. 719 This Water Well Record was completed on (mo/day/year) 10/27/2014 under the business name of Below Ground Surface, Inc. by (signature)

INSTRUCTIONS: Use typewriter or ball point pen. PLEASE PRESS FIRMLY and PRINT clearly. Please fill in blanks and check the correct answers. Send three copies (white, blue, pink) to Kansas Department of Health and Environment, Bureau of Water, Geology Section, 1000 SW Jackson St., Suite 420, Topeka, Kansas 66612-1367. Telephone 785-296-5524. Send one copy to WATER WELL OWNER and retain one for your records. I include fee of \$5.00 for each constructed well. Visit us at http://www.kdheks.gov/waterwell/index.html.