

AOC E-10

WATER WELL RECORD


Form WWC-5

Division of Water Resources App. No.

1 LOCATION OF WATER WELL: County: Butler Fraction SE 1/4 SE 1/4 NW 1/4 SW 1/4 Section Number 27 Township No. T 27 S Range Number R 4 [X]E []W

Street/Rural Address of Well Location; if unknown, distance & direction from nearest town or intersection: Former August Refinery; W. 2nd Ave., Augusta, KS Global Positioning System (GPS) information: Latitude: 37.668526 Longitude: 96.985523

2 WATER WELL OWNER: Williams Petroleum Services RR#, Street Address, Box #: One Williams Center City, State, ZIP Code : Tulsa, OK 74101

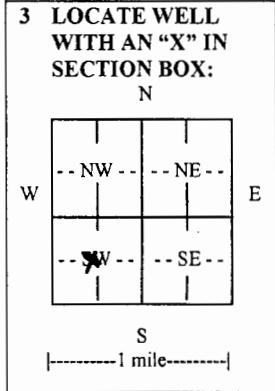

3 LOCATE WELL WITH AN 'X' IN SECTION BOX: N W E S 4 DEPTH OF COMPLETED WELL 17.5 ft. Depth(s) Groundwater Encountered (1) 17.5 ft. (2) ft. (3) ft. WELL'S STATIC WATER LEVEL 9.75 ft. below land surface measured on mo/day/yr. Domestic-lawn & garden [X] Monitoring well Was a chemical/bacteriological sample submitted to Department? [] Yes [X] No If yes, mo/day/yr sample was submitted. Water well disinfected? [] Yes [X] No

5 TYPE OF CASING USED: [] Steel [X] PVC [] Other CASING JOINTS: [] Glued [] Clamped [] Welded [X] Threaded Casing diameter 2 in. to 7.5 ft., Diameter 2 in. to 7.5 ft., Diameter 2 in. to 7.5 ft. Casing height above land surface 30 in., Weight lbs./ft., Wall thickness or gauge No. Sch. 40 TYPE OF SCREEN OR PERFORATION MATERIAL: [] Steel [] Stainless Steel [X] PVC [] Brass [] Galvanized Steel [] None used (open hole) [] Other (Specify) SCREEN OR PERFORATION OPENINGS ARE: [] Continuous slot [X] Mill slot [] Gauze wrapped [] Torch cut [] Drilled holes [] None (open hole) [] Louvered shutter [] Key punched [] Wire wrapped [] Saw 

6 GROUT MATERIAL: [] Neat cement [] Cement grout [X] Bentonite [] Other Grout Intervals: From 5.5 ft. to 2 ft., From 2 ft. to 2 ft., From 2 ft. to 2 ft. What is the nearest source of possible contamination: [] Septic tank [] Lateral lines [] Pit privy [] Livestock pens [] Insecticide storage [] Other (specify below) [] Sewer lines [] Cesspool [] Sewage lagoon [X] Fuel storage [] Abandoned water well [] Watertight sewer lines [] Seepage pit [] Feedyard [] Fertilizer storage [] Oil well/gas well Direction from well Distance from well

Table with 3 columns: FROM, TO, LITHOLOGIC LOG. Row 1: FROM 0, TO 17.5, LITHOLOGIC LOG Silty Clay. Other rows are empty.

7 CONTRACTOR'S OR LANDOWNER'S CERTIFICATION: This water well was constructed reconstructed, or plugged under my jurisdiction and was completed on (mo/day/year) 5/19/14 and this record is true to the best of my knowledge and belief. Kansas Water Well Contractor's License No. 710. This Water Well Record was completed on (mo/day/year) 10/27/2014 under the business name of Below Ground Services, Inc. by (signature) [Signature]

INSTRUCTIONS: Use typewriter or ball point pen. PLEASE PRESS FIRMLY and PRINT clearly. Please fill in blanks and check the correct answers. Send three copies (white, blue, pink) to Kansas Department of Health and Environment, Bureau of Water, Geology Section, 1000 SW Jackson St., Suite 420, Topeka, Kansas 66612-1367. Telephone 785-296-5524. Send one copy to WATER WELL OWNER and retain one for your records. I include fee of \$5.00 for each constructed well. Visit us at http://www.kdheks.gov/waterwell/index.html.