

WATER WELL RECORD

Form WWC-5

Division of Water Resources App. No.


Well ID

MW4

Original Record Correction Change in Well Ust

1 LOCATION OF WATER WELL: County Butler Fraction NE 1/4 NE 1/4 NW 1/4 NW 1/4 Section Number 27 Township Number T 27 S Range Number R 4 E W

2 WELL OWNER: Last Name: Business: KDHE Address: 1000 SW Jackson Blvd City: Topeka State: KS ZIP: 66046 Street or Rural Address where well is located (if unknown, distance and direction from nearest town or intersection): 715 W 7th St., Augusta, KS

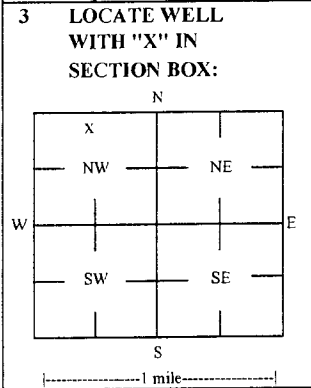

4 DEPTH OF COMPLETED WELL: 20 ft Depth(s) Groundwater Encountered: 1) 10.93 ft 2) Dry Well WELL'S STATIC WATER LEVEL: 10.93 ft

5 Latitude: 37.67921 (decimal degrees) Longitude: 96.98620 (decimal degrees) Horizontal Datum: WGS 84 NAD 83 NAD 27 Source for Latitude/Longitude: GPS (unit make/model): Land Survey Topographic Map Online Mapper

7 WELL WATER TO BE USED AS: 1 Domestic: 2 Irrigation 3 Feedlot 4 Industrial 5 Public Water Supply: well ID 6 Dewatering: how many wells? 7 Aquifer Recharge: well ID 8 Monitoring: well ID MW4 9 Environmental Remediation: well ID 10 Oil Field Water Supply: lease 11 Test Hole: well ID 12 Geothermal: How many bores?

Was a chemical/bacteriological sample submitted to KDHE? Yes No Water well disinfected? Yes No If yes, date sample was submitted:

8 TYPE OF CASING USED: Steel PVC Other CASING JOINTS: Glued Clamped Welded Threaded Casing diameter 2 in. to 10 ft. Diameter in. to ft. Diameter in. to ft. Casing height above land surface -0.34 in. Weight lbs./ft. Well thickness or gauge No

9 GROUT MATERIAL: Neat cement Cement grout Bentonite Other Concrete: 0-1' Grout intervals: From 1 ft. to 8 ft. From ft. to ft. From ft. to ft.

Nearest source of possible contamination: Septic Tank Lateral Lines Pit Privy Livestock Pens Insecticide Storage Sewer Lines Cess Pool Sewage Lagoon Fuel Storage Abandoned Water Well Watertight Sewer Lines Seepage Pit Feedyard Fertilizer Storage Oil Well / Gas Well

Table with columns: 10 FROM TO LITHOLOGIC LOG FROM TO LITHO. LOG (cont.) or PLUGGING INTERVALS. Rows: 0 to 0.4 Concrete, 0.4 to 22 Silty clay, 22 to 25 Sandy silty clay. Note: 5 feet were lost due to flowing sand.

Notes: KDHE ID: Herbert Phillips Property Target of monitoring well is shallow groundwater, <20' of grout was installed at the direction of KDHE.

11 CONTRACTOR'S OR LANDOWNER'S CERTIFICATION: This water well was constructed, reconstructed, or plugged under my jurisdiction and was completed on (mo-day-year) 7/18/17 and this record is true to the best of my knowledge and belief. Kansas Water Well Contractor's License No 757 This Water Well Record was completed on (mo-day-year) 8/13/17 under the business name of Larsen & Associates, Inc. Signature

# DENNIS L HANDKE

1820 NW 59th Terrace  
TOPEKA, KANSAS 66618  
785-286-4047 Home  
785-286-1990 Fax

Jess Chapman  
Larsen & Assoc.  
1311 E. 25<sup>th</sup> St., Suite B  
Topeka, Kansas 66046

August 3, 2017

RECEIVED

SEP 01 2017

BUREAU OF WATER

RE: Monitor Well Elevation Survey  
715 W. 7<sup>th</sup> St., Augusta, Kansas

Proj. 17-00X  
Herbert Phillips Property  
KDHE ID U2-008-14368

Bench Mark: Square cut on NW corner of concrete signal light sign base at the NE Corner of property.  
Elev.: 1224.71      North 5245      West 4338      (from SE Cor. Sec. 27-27-4E)

MW-1	rim	1224.90	North 5109	NW1/4,NE1/4,NW1/4,NW1/4
	top pipe	1224.48	West 4378	Lat = 37.67889    Long = 96.98666
MW-2	rim	1224.67	North 5140	NW1/4,NE1/4,NW1/4,NW1/4
	top pipe	1224.33	West 4520	Lat = 37.67897    Long = 96.98713
MW-3	rim	1226.08	North 5191	NW1/4,NE1/4,NW1/4,NW1/4
	top pipe	1225.39	West 4349	Lat = 37.67911    Long = 96.98656
MW-4	rim	1223.31	North 5225	NE1/4,NE1/4,NW1/4,NW1/4
	top pipe	1222.97	West 4245	Lat = 37.67921    Long = 96.98620
MW-5	rim	1224.78	North 4990	NW1/4,NE1/4,NW1/4,NW1/4
	top pipe	1224.41	West 4352	Lat = 37.67856    Long = 96.98657
MW-6	rim	1224.98	North 4981	NW1/4,NE1/4,NW1/4,NW1/4
	top pipe	1224.64	West 4514	Lat = 37.67854    Long = 96.98713
MW-7	rim	1225.19	North 5212	NE1/4,NW1/4,NW1/4,NW1/4
	top pipe	1224.76	West 4564	Lat = 37.67917    Long = 96.98730
MW-8	rim	1223.33	North 5068	NE1/4,NW1/4,NW1/4,NW1/4
	top pipe	1222.89	West 4690	Lat = 37.67878    Long = 96.98773
MW-9	rim	1224.39	South 4585	NW1/4,SE1/4,NW1/4,NW1/4
	top pipe	1224.10	West 4626	Lat = 37.67745    Long = 96.98751

Lat & Long derived from Augusta 7.5' quad map. WGS84.

Elevation derived from USGS BM X-39 NAVD 88.

If you have any questions, please feel free to call me. Thank you for the opportunity to be of service to you.

August 3, 2017  
Dennis L Handke, RLS  
LS-786

Dennis L Handke  
KANSAS  
LAND SURVEYOR