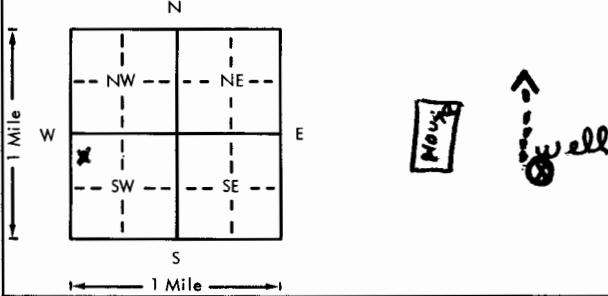


USE TYPEWRITER OR BALL
POINT PEN-PRESS FIRMLY,
PRINT CLEARLY..

WATER WELL RECORD
KSA 82a-1201-1215

Kansas Department of Health and
Environment-Division of Environment
(Water well Contractors)
Topeka, Kansas 66620

1. Location of well:	County <i>Butler</i>	Fraction <i>NW^{1/4} NW^{1/4} SW^{1/4}</i>	Section number <i>1</i>	Township number <i>T 27 S R 4 NW</i>	Range number
2. Distance and direction from nearest town or city:	<i>2N. 1 E.</i>	<i>N</i>	3. Owner of well: R.R. or street: City, state, zip code:	<i>James M C Queen R#1 El Dorado Kans</i>	
4. Locate with "X" in section below:	Sketch map: 		6. Bore hole dia. <u>10</u> in. Completion date <u>6-10-77</u> Well depth <u>50</u> ft.		
			7. <input checked="" type="checkbox"/> Cable tool <u>Rotary</u> <u>Driven</u> <u>Dug</u> <u>Hollow rod</u> <u>Jetted</u> <u>Bored</u> <u>Reverse rotary</u>		
			8. Use: <input checked="" type="checkbox"/> Domestic <u>Public supply</u> <u>Industry</u> <u>Irrigation</u> <u>Air conditioning</u> <u>Stock</u> <u>Lawn</u> <u>Oil field water</u> <u>Other</u>		
			9. Casing: Material <u>steel</u> Height: <u>Above</u> or below Threaded <u>Welded</u> <u>gl</u> Surface <u>14</u> in. RMP <u>4</u> PVC <u>Weight</u> <u>lbs./ft.</u> Dia. <u>6</u> in. to <u>50</u> ft. depth Wall Thickness: inches or Dia. <u>6</u> in. to <u>50</u> ft. depth Gage No. <u>175</u>		
5. Type and color of material	From	To	10. Screen: Manufacturer's name <u>g & Z</u> Type <u>RMP</u> Dia. <u>6</u> Slo/gauze <u>1/4</u> Length <u>20</u> Set between <u>30</u> ft. and <u>50</u> ft. ft. and <u>50</u> ft. Gravel pack? <u>no</u> Size range of material _____		
			11. Static water level: <u>19</u> ft. below land surface Date <u>6-10-77</u>		
			12. Pumping level below land surfaces: ft. after <u>hrs.</u> pumping <u>g.p.m.</u> ft. after <u>hrs.</u> pumping <u>g.p.m.</u> Estimated maximum yield <u>19</u> g.p.m.		
			13. Water sample submitted: <u>mo./day/yr.</u> Yes <input checked="" type="checkbox"/> No Date _____		
			14. Well head completion: <u>Pitless adapter</u> <u>14</u> Inches above grade		
			15. Well grouted? <u>yes</u> With: <input checked="" type="checkbox"/> Neat cement <u>Bentonite</u> <u>Concrete</u> Depth: From <u>0</u> ft. to <u>10</u> ft.		
			16. Nearest source of possible contamination: ft. <u>80</u> Direction <u>north</u> Type <u>Septic</u> Well disinfected upon completion? <input checked="" type="checkbox"/> Yes <u>No</u>		
			17. Pump: <input checked="" type="checkbox"/> Not installed Manufacturer's name _____ Model number _____ HP _____ Volts _____ Length of drop pipe _____ ft. capacity _____ g.p.m. Type: <u>Submersible</u> <u>Turbine</u> <u>Jet</u> <u>Reciprocating</u> <u>Centrifugal</u> <u>Other</u>		
(Use a second sheet if needed)					
18. Elevation:	19. Remarks:	owner has slab and well house over well.			
Topography: <input type="checkbox"/> Hill <input type="checkbox"/> Slope <input checked="" type="checkbox"/> Upland <input type="checkbox"/> Valley	20. Water well contractor's certification: This well was drilled under my jurisdiction and this report is true to the best of my knowledge and belief. <u>Wise well drilling 122</u> Business name <u>But 3 Box 517 Augusta</u> License No. _____ Address _____ Signed <u>James W. Weller</u> Date <u>6-10-77</u> Authorized representative _____				