

WATER WELL RECORD Form WWC-5 KSA 82a-1212


1 LOCATION OF WATER WELL		Fraction SW $\frac{1}{4}$	NW $\frac{1}{4}$	SW $\frac{1}{4}$	Section Number 5	Township Number T 27 S	Range Number R 4 E 11
--------------------------	--	------------------------------	------------------	------------------	---------------------	---------------------------	--------------------------

County: BUTLER 015 Distance and direction from nearest town or city street address of well if located within city?

1 E, of Santa Fe Lake Road, $\frac{1}{4}$ N, West Side of 29th No. ✓

2 WATER WELL OWNER:	Grover White Construction	SPEC. HOUSE
RR#, St. Address, Box # :	R. R. #1 Box 179A	Board of Agriculture, Division of Water Resources
City, State, ZIP Code	Mulvane, Ks.	Application Number:

3 LOCATE WELL'S LOCATION WITH AN "X" IN SECTION BOX:	4 DEPTH OF COMPLETED WELL 80 ft. ELEVATION: ft. ft. ft. ft.
--	---

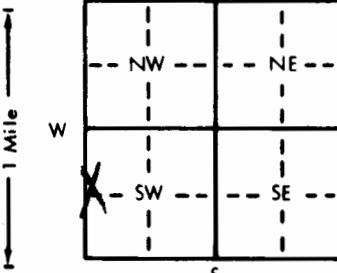

Depth(s) Groundwater Encountered 1. 20 ft. 2. ft. 3. ft.
--

WELL'S STATIC WATER LEVEL 20 ft. below land surface measured on mo/day/yr 7-18-84 ✓

Pump test data: Well water was ft. after hours pumping gpm
--

Est. Yield 111 gpm: Well water was ft. after hours pumping gpm
--

Bore Hole Diameter 11 in. to 30 ft., and in. to ft.

WELL WATER TO BE USED AS: 5 Public water supply 8 Air conditioning 11 Injection well
--

1 Domestic 3 Feedlot 6 Oil field water supply 9 Dewatering 12 Other (Specify below)

2 Irrigation 4 Industrial 7 Lawn and garden only 10 Observation well
--

Was a chemical/bacteriological sample submitted to Department? Yes No X If yes, mo/day/yr sample was submitted
--

Water Well Disinfected? Yes X No

5 TYPE OF BLANK CASING USED: 1 Steel 2 PVC 3 RMP (SB) 4 ABS 5 Wrought iron 6 Asbestos-Cement 7 Fiberglass 8 Concrete tile 9 Other (specify below) 10 Asbestos-cement
--

Blank casing diameter 5 in. to 20 ft., Dia in. to ft., Dia in. to ft.

Casing height above land surface 12 in., weight 1.59 lbs./ft. Wall thickness or gauge No. 203

TYPE OF SCREEN OR PERFORATION MATERIAL: 1 Steel 2 Brass 3 Stainless steel 4 Galvanized steel 5 Fiberglass 6 Concrete tile 7 PVC 8 RMP (SR) 9 ABS 10 Asbestos-cement

SCREEN OR PERFORATION OPENINGS ARE: 1 Continuous slot 2 Louvered shutter 3 Mill slot 4 Key punched 5 Gauzed wrapped 6 Wire wrapped 7 Torch cut 8 Saw cut 9 Drilled holes 10 Other (specify) 11 None (open hole)

SCREEN-PERFORATED INTERVALS: From 20 ft. to 80 ft., From ft. to ft.

From ft. to ft., From ft. to ft.
--

GRAVEL PACK INTERVALS: From 14 ft. to 80 ft., From ft. to ft.

From ft. to ft., From ft. to ft.
--

6 GROUT MATERIAL: 1 Neat cement 2 Cement grout 3 Bentonite 4 Other
--

Grout Intervals: From 4 ft. to 14 ft., From ft. to ft., From ft. to ft., From ft. to ft.
--

What is the nearest source of possible contamination: 1 Septic tank 2 Sewer lines 3 Watertight sewer lines 4 Lateral lines 5 Cess pool 6 Seepage pit 7 Pit privy 8 Sewage lagoon 9 Feedyard 10 Livestock pens 11 Fuel storage 12 Fertilizer storage 13 Insecticide storage 14 Abandoned water well 15 Oil well/Gas well 16 Other (specify below)
--

None. Apparent How many feet?

Direction from well? FROM TO LITHOLOGIC LOG FROM TO LITHOLOGIC LOG
--

0 3 Tospoil

3 10 01 Clay

10 52 Brown Shale

52 80 19 Gray Shale

7 CONTRACTOR'S OR LANDOWNER'S CERTIFICATION: This water well was (1) constructed, (2) reconstructed, or (3) plugged under my jurisdiction and was completed on (mo/day/year) 7-18-84 and this record is true to the best of my knowledge and belief. Kansas

Water Well Contractor's License No. 236 This Water Well Record was completed on (mo/day/yr) 11-1-84

under the business name Sharp Well & Pump Service, Inc. by (signature) <i>Mary Arnold</i>

INSTRUCTIONS: Use typewriter or ball point pen, PLEASE PRESS FIRMLY and PRINT clearly. Please fill in blanks, underline or circle the correct answers. Send top three copies to Kansas Department of Health and Environment, Division of Environment, Environmental Geology Section, Topeka, KS 66620. Send one to WATER WELL OWNER and retain one for your records.
--