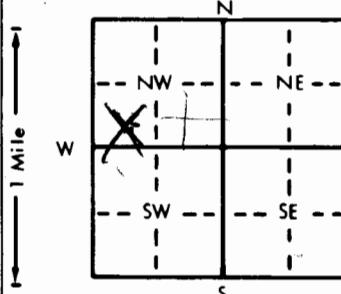


1 LOCATION OF WATER WELL:	Fraction County: <i>Butler</i>	Section Number SW 1/4 SW 1/4 NW 1/4	Township Number T 27 S	Range Number R 4 E
---------------------------	-----------------------------------	--	---------------------------	-----------------------

Distance and direction from nearest town or city street address of well if located within city?

*KELLOGG & LILLY LAKE Rd. 2 mi. NO. 1W. 1 1/2 NO. E. side*2 WATER WELL OWNER: *TERRY FARNEY*RR#, St. Address, Box # *107 Cheniere*City, State, ZIP Code *Rose Hill, KS 67133*Board of Agriculture, Division of Water Resources
Application Number:3 LOCATE WELL'S LOCATION WITH
AN "X" IN SECTION BOX:4 DEPTH OF COMPLETED WELL *60* ft. ELEVATION:Depth(s) Groundwater Encountered *1 30* ft. 2. ft. 3. ft.WELL'S STATIC WATER LEVEL *30* ft. below land surface measured on mo/day/yr *5/10/90*

Pump test data: Well water was ft. after hours pumping gpm

Est. Yield gpm: Well water was ft. after hours pumping gpm

Bore Hole Diameter *10* in. to ft., and in. to ft.

WELL WATER TO BE USED AS: 5 Public water supply 8 Air conditioning 11 Injection well

1 Domestic 3 Feedlot 6 Oil field water supply 9 Dewatering 12 Other (Specify below)

2 Irrigation 4 Industrial 7 Lawn and garden only 10 Monitoring well

Was a chemical/bacteriological sample submitted to Department? Yes No If yes, mo/day/yr sample was submitted

Water Well Disinfected? Yes No

5 TYPE OF BLANK CASING USED:

1 Steel 3 RMP (SR)

2 PVC

Blank casing diameter *5* in. to ft., Dia in. to ft., Dia in. to ft.Casing height above land surface *+12* in., weight *200* lbs./ft. Wall thickness or gauge No.

TYPE OF SCREEN OR PERFORATION MATERIAL:

1 Steel 3 Stainless steel

2 Brass 4 Galvanized steel

SCREEN OR PERFORATION OPENINGS ARE:

1 Continuous slot 3 Mill slot

2 Louvered shutter 4 Key punched

SCREEN-PERFORATED INTERVALS: From *40* ft. to *60* ft. From ft. to ft.GRAVEL PACK INTERVALS: From *20* ft. to *60* ft. From ft. to ft.

From ft. to ft. From ft. to ft.

6 GROUT MATERIAL: 1 Neat cement 2 Cement grout 3 Bentonite 4 Other

Grout Intervals: From *0* ft. to *20* ft., From ft. to ft., From ft. to ft.

What is the nearest source of possible contamination:

1 Septic tank 4 Lateral lines 7 Pit privy 10 Livestock pens 14 Abandoned water well

2 Sewer lines 5 Cess pool 8 Sewage lagoon 11 Fuel storage 15 Oil well/Gas well

3 Watertight sewer lines 6 Seepage pit 9 Feedyard 12 Fertilizer storage 16 Other (specify below)

13 Insecticide storage

How many feet? *+100*Direction from well? *DOWN SLOPE*

7 LITHOLOGIC LOG

FROM TO

0 5 *Loam*5 25 *Yellow Clay*25 50 *Gray shale*50 60 *Shaly lime*

FROM TO

PLUGGING INTERVALS

PLUGGED

AUG 2 1990

DIVISION OF

7 CONTRACTOR'S OR LANDOWNER'S CERTIFICATION: This water well was (1) constructed, (2) reconstructed, or (3) plugged under my jurisdiction and was completed on (mo/day/year) *5/10/90* and this record is true to the best of my knowledge and belief. KansasWater Well Contractor's License No. *493* This Water Well Record was completed on (mo/day/year) *5/10/90* by (signature) *DeWayne Raisbeck*under the business name of *Reiserer Well Drilling*

INSTRUCTIONS: Use typewriter or ball point pen. PLEASE PRESS FIRMLY and PRINT clearly. Please fill in blanks, underline or circle the correct answers. Send top three copies to Kansas Department of Health and Environment, Bureau of Water Protection, Topeka, Kansas 66620-7320. Telephone: 913-296-5514. Send one to WATER WELL OWNER and retain one for your records.