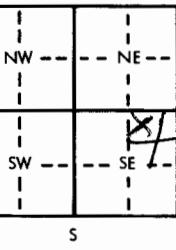
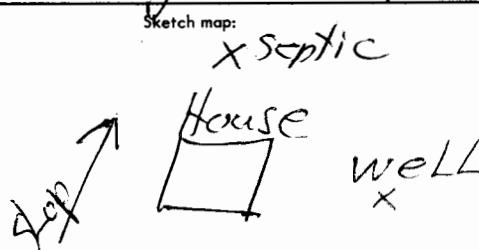


USE TYPEWRITER OR BALL
POINT PEN-PRESS FIRMLY,
PRINT CLEARLY.

WATER WELL RECORD
KSA 82a-1201-1215

Kansas Department of Health and
Environment-Division of Environment
(Water well Contractors)
Topeka, Kansas 66620

1. Location of well:	County Butler	Fraction NW_{1/4} NE_{1/4} SE_{1/4}	Section number 6	Township number T 27 S	Range number R 4 EW
2. Distance and direction from nearest town or city:	4W 4N		3. Owner of well:	R. H. Hart, 11th and 21st Street, Apt. 204, Augusta, Kansas 67002	
Street address of well location if in city:	of Augusta		R.R. or street:	21 ^{1/2} th Street	
4. Locate with "X" in section below:			Sketch map:		
5. Type and color of material	From	To	6. Bore hole dia. 8 in. Completion date 4/17/77 Well depth 100 ft.		
Soil	0	5	7. <input checked="" type="checkbox"/> Cable tool <input type="checkbox"/> Rotary <input type="checkbox"/> Driven <input type="checkbox"/> Dug <input type="checkbox"/> Hollow rod <input type="checkbox"/> Jetted <input type="checkbox"/> Bored <input type="checkbox"/> Reverse rotary		
Clay	5	10	8. Use: <input checked="" type="checkbox"/> Domestic <input type="checkbox"/> Public supply <input type="checkbox"/> Industry <input type="checkbox"/> Irrigation <input type="checkbox"/> Air conditioning <input type="checkbox"/> Stock <input type="checkbox"/> Lawn <input type="checkbox"/> Oil field water <input type="checkbox"/> Other		
Rock	10	25	9. Casing: Material PS Height: Above or below Threaded <input type="checkbox"/> Welded <input checked="" type="checkbox"/> Surface 18 in. RMP X PVC Weight 100 lbs./ft. Dia. 5 in. to 100 ft. depth Wall Thickness: inches or Dia. 5 in. to 100 ft. depth gage No. A 1/2		
Clay yellow	25	35	10. Screen: Manufacturer's name Screen Flower		
Shale	35	50	Type 100 Dia. 5 Slot/gauze 1/16 Length 30 Set between 60 ft. and 80 ft. ft. and 80 ft. Gravel pack? None Size range of material		
Water — Lime	50	100	11. Static water level: 50 ft. below land surface Date 4/17/77 mo./day/yr.		
			12. Pumping level below land surfaces: 60 ft. after 1 hrs. pumping 9 p.m. 60 ft. after hrs. pumping 9 p.m. Estimated maximum yield 20 g.p.m.		
			13. Water sample submitted: Yes <input checked="" type="checkbox"/> No Date		
			14. Well head completion: Pitless adapter Inches above grade		
			15. Well grouted? Yes With: <input type="checkbox"/> Neat cement <input type="checkbox"/> Bentonite <input checked="" type="checkbox"/> Concrete Depth: From 0 ft. to 10 ft.		
			16. Nearest source of possible contamination: ft. 100 Direction NE Type Septic		
			Well disinfected upon completion? Yes <input checked="" type="checkbox"/> No		
			17. Pump: X Not installed Manufacturer's name _____ Model number _____ HP _____ Volts _____ Length of drop pipe _____ ft. capacity _____ g.p.m. Type: <input type="checkbox"/> Submersible <input type="checkbox"/> Turbine <input type="checkbox"/> Jet <input type="checkbox"/> Reciprocating <input type="checkbox"/> Centrifugal <input type="checkbox"/> Other		
(Use a second sheet if needed)			18. Elevation: 19. Remarks:		
Topography: <input type="checkbox"/> Hill <input type="checkbox"/> Slope <input checked="" type="checkbox"/> Upland <input type="checkbox"/> Valley			20. Water well contractor's certification: This well was drilled under my jurisdiction and this report is true to the best of my knowledge and belief. Winter Well Drill Business name 123 Box 30 Augusta, Kansas License No. Address 123 Box 30 Augusta, Kansas Date 3/17/80 Signed Charles Winter Authorized representative		