

1 LOCATION OF WATER WELL	Fraction County: Butler	NE $\frac{1}{4}$ SW $\frac{1}{4}$ NE $\frac{1}{4}$	Section Number 6	Township Number T 27 S	Range Number R 4 E
--------------------------	----------------------------	--	---------------------	---------------------------	-----------------------

Distance and direction from nearest town or city? 3 W 3 N
1 E IN OF Augusta

Street address of well if located within city?

2 WATER WELL OWNER: Richard Waltman

RR#, St. Address, Box # RR# 11
City, State, ZIP Code RI Augusta KenBoard of Agriculture, Division of Water Resources
Application Number:

3 DEPTH OF COMPLETED WELL 84 ft. Bore Hole Diameter 8 1/2 in. to ft. and in. to ft.

Well Water to be used as: 5 Public water supply 8 Air conditioning 11 Injection well

1 Domestic 3 Feedlot 6 Oil field water supply 9 Dewatering 12 Other (Specify below)

2 Irrigation 4 Industrial 7 Lawn and garden only 10 Observation well

Well's static water level 40 ft. below land surface measured on 9 month 12 day 80 year

Pump Test Data Well water was 50 ft. after 200 hours pumping gpm

Est. Yield 20 gpm Well water was ft. after 200 hours pumping gpm

4 TYPE OF BLANK CASING USED: 5 Wrought iron 8 Concrete tile Casing Joints: Glued X Clamped

1 Steel 3 RMP (SR) 6 Asbestos-Cement Welded

2 PVC 4 ABS 7 Fiberglass Threaded

Blank casing dia 5 in. to 84 ft. Dia in. to ft. Dia in. to ft.

Casing height above land surface 18 in., weight 200 lbs./ft. Wall thickness or gauge No. 2 1/4

TYPE OF SCREEN OR PERFORATION MATERIAL: 7 PVC 10 Asbestos-cement

1 Steel 3 Stainless steel 5 Fiberglass 8 RMP (SR) 11 Other (specify)

2 Brass 4 Galvanized steel 6 Concrete tile 9 ABS 12 None used (open hole)

Screen or Perforation Openings Are: 5 Gauzed wrapped 8 Saw cut 11 None (open hole)

1 Continuous slot 3 Mill slot 6 Wire wrapped

2 Louvered shutter 4 Key punched 7 Torch cut 10 Other (specify)

Screen-Perforation Dia 5 in. to 84 ft., Dia in. to ft., Dia in. to ft.

Screen-Perforated Intervals: From 64 ft. to 84 ft., From ft. to ft., From ft. to ft.

Gravel Pack Intervals: From ft. to ft., From ft. to ft., From ft. to ft.

From ft. to ft., From ft. to ft., From ft. to ft.

5 GROUT MATERIAL: 1 Neat cement 2 Cement grout 3 Bentonite 4 Other

Grouted Intervals: From 0 ft. to 10 ft., From ft. to ft., From ft. to ft., From ft. to ft.

What is the nearest source of possible contamination:

1 Septic tank 4 Cess pool 7 Sewage lagoon 10 Fuel storage 14 Abandoned water well

2 Sewer lines 5 Seepage pit 8 Feed yard 11 Fertilizer storage 15 Oil well/Gas well

3 Lateral lines 6 Pit privy 9 Livestock pens 12 Insecticide storage 16 Other (specify below)

Direction from well W How many feet 120 ? Water Well Disinfected? Yes No

Was a chemical/bacteriological sample submitted to Department? Yes No If yes, date sample

was submitted month day year: Pump Installed? Yes No

If Yes: Pump Manufacturer's name Model No. HP Volts

Depth of Pump Intake ft. Pumps Capacity rated at gal./min.

Type of pump: 1 Submersible 2 Turbine 3 Jet 4 Centrifugal 5 Reciprocating 6 Other

6 CONTRACTOR'S OR LANDOWNER'S CERTIFICATION: This water well was (1) constructed, (2) reconstructed, or (3) plugged under my jurisdiction and was


completed on 9 month 12 day 80 year

and this record is true to the best of my knowledge and belief. Kansas Water Well Contractor's License No. 257

This Water Well Record was completed on 9 month 16 day 80 year under the business

name of Winter Well Drilling by (signature) Charles Winter

7 LOCATE WELL'S LOCATION WITH AN "X" IN SECTION BOX:

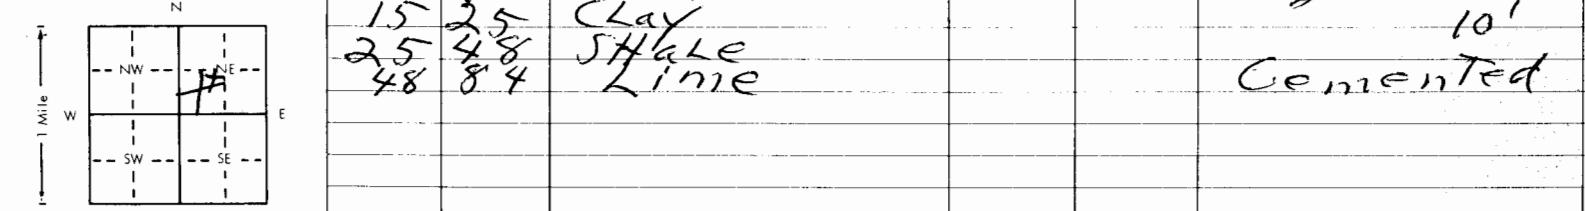

ELEVATION: 1. 65 ft. 2. ft. 3. ft. 4. ft. (Use a second sheet if needed)

Depth(s) Groundwater Encountered 1. 65 ft. 2. ft. 3. ft. 4. ft. (Use a second sheet if needed)

INSTRUCTIONS: Use typewriter or ball point pen, please press firmly and PRINT clearly. Please fill in blanks, underline or circle the correct answers. Send top three copies to Kansas Department of Health and Environment, Division of Environment, Water Well Contractors, Topeka, KS 66620. Send one to WATER WELL OWNER and retain one for your records.

OFFICE USE ONLY