

1 LOCATION OF WATER WELL:	Fraction	Section Number	Township Number	Range Number
County: Butler	SW 1/4 NW 1/4 SE 1/4	8	T 27 S	R 4 E

Distance and direction from nearest town or city street address of well if located within city?

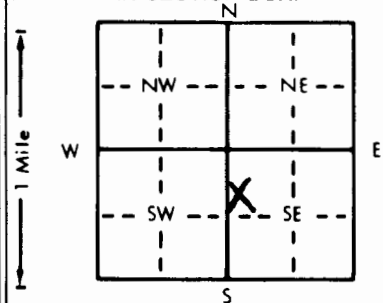
2 mi. West of Augusta2 WATER WELL OWNER: **BLAIR CONSTRUCTION, Inc.**RR#, St. Address, Box # : **P.O. Box 276**

Board of Agriculture, Division of Water Resources

City, State, ZIP Code : **ANDOVER, KS. 67002**

Application Number:

3 LOCATE WELL'S LOCATION WITH AN "X" IN SECTION BOX:

4 DEPTH OF COMPLETED WELL: **120** ft. ELEVATION:Depth(s) Groundwater Encountered 1. **110** ft. 2. ft. 3. ft.WELL'S STATIC WATER LEVEL **42** ft. below land surface measured on mo/day/yr **6/2/92**

Pump test data: Well water was ft. after hours pumping gpm

Est. Yield **50** gpm: Well water was ft. after hours pumping gpmBore Hole Diameter **10** in. to ft., and in. to ft.

WELL WATER TO BE USED AS: 5 Public water supply 8 Air conditioning 11 Injection well

1 **Domestic** 3 Feedlot 6 Oil field water supply 9 Dewatering 12 Other (Specify below)

2 Irrigation 4 Industrial 7 Lawn and garden only 10 Monitoring well

Was a chemical/bacteriological sample submitted to Department? Yes No ☒ If yes, mo/day/yr sample was submittedWater Well Disinfected? Yes ☒ No

5 TYPE OF BLANK CASING USED:

- 1 Steel
2 **PVC**
3 RMP (SR)
4 ABS

- 5 Wrought iron
6 Asbestos-Cement
7 Fiberglass
8 Concrete tile
9 Other (specify below)

CASING JOINTS: Glued Clamped

Welded

Threaded

Blank casing diameter **5** in. to ft., Dia in. to ft., Dia in. to ft.Casing height above land surface **12** in., weight **160** lbs./ft. Wall thickness or gauge No.

TYPE OF SCREEN OR PERFORATION MATERIAL:

- 1 Steel
2 Brass
3 Stainless steel
4 Galvanized steel

- 5 Fiberglass
6 Concrete tile
7 **PVC**
8 **RMP (SR)**
9 ABS

10 Asbestos-cement

11 Other (specify)

12 None used (open hole)

SCREEN OR PERFORATION OPENINGS ARE:

- 1 Continuous slot
2 Louvered shutter
3 **Mill slot**
4 Key punched

5 Gauzed wrapped

6 Wire wrapped

7 Torch cut

8 Saw cut

9 Drilled holes

10 Other (specify)

11 None (open hole)

SCREEN-PERFORATED INTERVALS: From **100** ft. to **120** ft., From ft. to ft.

From ft. to ft., From ft. to ft.

GRAVEL PACK INTERVALS: From **20** ft. to **120** ft., From ft. to ft.

From ft. to ft., From ft. to ft.

6 GROUT MATERIAL:

1 Neat cement

2 Cement grout

3 **Bentonite**

4 Other

Grout intervals: From **20** ft. to **3** ft., From ft. to ft., From ft. to ft.

What is the nearest source of possible contamination:

- 1 Septic tank
2 Sewer lines
3 Watertight sewer lines
4 Lateral lines
5 Cess pool
6 Seepage pit

- 7 Pit privy
8 **Sewage lagoon**
9 Feedyard

10 Livestock pens

11 Fuel storage

12 Fertilizer storage

13 Insecticide storage

14 Abandoned water well

15 Oil well/Gas well

16 Other (specify below)

Direction from well?

down slopeHow many feet? **100 +**

FROM	TO	LITHOLOGIC LOG	FROM	TO	PLUGGING INTERVALS
0	1	earth			
1	25	broken lime			
25	45	grey shale			
45	62	lime			
62	80	shaley lime			
80	86	red bed			
86	104	shaley lime			
104	120	Sandy lime water			

7 CONTRACTOR'S OR LANDOWNER'S CERTIFICATION: This water well was (1) constructed, (2) reconstructed, or (3) plugged under my jurisdiction and was completed on (mo/day/year) **6/2/92** and this record is true to the best of my knowledge and belief. KansasWater Well Contractor's License No. **493** This Water Well Record was completed on (mo/day/yr)under the business name of **BLAIR CONSTRUCTION, Inc.**by (signature) **Johnny R. Risher**