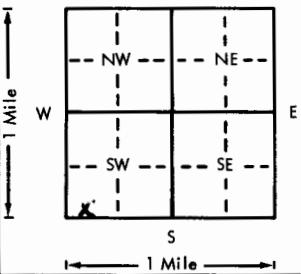


Supt 5-16-77

USE TYPEWRITER OR BALL
POINT PEN-PRESS FIRMLY,
PRINT CLEARLY.

WATER WELL RECORD
KSA 82a-1201-1215

Kansas Department of Health and
Environment-Division of Environment
(Water well Contractors)
Topeka, Kansas 66620

1. Location of well:	County Butler	Fraction SW 1/4 SW 1/4 SW 1/4	Section number 11	Township number T 27	Range number S R 4 NW
2. Distance and direction from nearest town or city:	1 M. N of Augusta Kans		3. Owner of well: R.R. or street: City, state, zip code:	L. A. T. nebler 1611 Highland Augusta Kans	
4. Locate with "X" in section below:	Sketch map: 		Well		
5. Type and color of material	From	To	6. Bore hole dia. 10 in. Completion date 7-21-1976 Well depth 40 ft.		
yellow lime	0	18	7. <input checked="" type="checkbox"/> Cable tool <input type="checkbox"/> Rotary <input type="checkbox"/> Driven <input type="checkbox"/> Dug <input type="checkbox"/> Hollow rod <input type="checkbox"/> Jetted <input type="checkbox"/> Bored <input type="checkbox"/> Reverse rotary		
grey lime	18	25	8. Use: <input type="checkbox"/> Domestic <input type="checkbox"/> Public supply <input type="checkbox"/> Industry <input checked="" type="checkbox"/> Irrigation <input type="checkbox"/> Air conditioning <input type="checkbox"/> Stock <input type="checkbox"/> Lawn <input type="checkbox"/> Oil field water <input type="checkbox"/> Other		
water	25		9. Casing: Material <input checked="" type="checkbox"/> pvc <input type="checkbox"/> Height Above ground below Threaded <input type="checkbox"/> Welded <input checked="" type="checkbox"/> Surface 5 ft in. RMP <input checked="" type="checkbox"/> PVC <input type="checkbox"/> Weight 1.5 lbs./ft. Dia. 6 in. to 40 ft. depth Wall thickness: inches or Dia. in. to ft. depth gage No. 175		
grey lime	2.5	40	10. Screen: Manufacturer's name <input checked="" type="checkbox"/> R.M.P.		
			Type <input checked="" type="checkbox"/> R.M.P. Dia. 6 in Slat gauze 1/16 Length 20 ft Set between 20 ft. and 40 ft. ft. and ft. Gravel pack? <input checked="" type="checkbox"/> No Size range of material		
			11. Static water level: mo./day/yr. 12 ft. below land surface Date 7-21-1976		
			12. Pumping level below land surfaces: ft. after hrs. pumping g.p.m. ft. after hrs. pumping g.p.m. Estimated maximum yield 25+ g.p.m.		
			13. Water sample submitted: mo./day/yr. Yes <input checked="" type="checkbox"/> No Date		
			14. Well head completion: Pitless adapter 5 ft inches above grade		
			15. Well grouted? <input checked="" type="checkbox"/> Yes With: <input checked="" type="checkbox"/> Neat cement <input type="checkbox"/> Bentonite <input type="checkbox"/> Concrete Depth: From 0 ft. to 10 ft.		
			16. Nearest source of possible contamination: m.n.t. ft. <input checked="" type="checkbox"/> Direction NE Type Sewer Well disinfected upon completion? Yes <input checked="" type="checkbox"/> No		
			17. Pump: Not installed Manufacturer's name Model number HP / Volts Length of drop pipe ft. capacity g.p.m. Type: <input type="checkbox"/> Submersible <input type="checkbox"/> Turbine <input type="checkbox"/> Jet <input type="checkbox"/> Reciprocating <input type="checkbox"/> Centrifugal <input type="checkbox"/> Other		
			18. Elevation: Topography: <input type="checkbox"/> Hill <input type="checkbox"/> Slope <input checked="" type="checkbox"/> Upland <input type="checkbox"/> Valley		
			19. Remarks: their will be a approx. 5 ft fill around the well and house. owner will put on slab L. A. nebler		
			20. Water well contractor's certification: This well was drilled under my jurisdiction and this report is true to the best of my knowledge and belief. Wise well drilling 122 Business name <input checked="" type="checkbox"/> License No. Address #3 Box 128L Augusta Signed <input checked="" type="checkbox"/> Murray Wilks Date 7-21-1976 Authorized representative		