


1 LOCATION OF WATER WELL: County: <u>Rutler</u>	Fraction <u>SW</u> $\frac{1}{4}$, <u>SW</u> $\frac{1}{4}$ <u>SW</u> $\frac{1}{4}$	Section Number <u>12</u>	Township Number T <u>27</u> S	Range Number R <u>4</u> <u>EW</u>
--	--	-----------------------------	----------------------------------	--------------------------------------

Distance and direction from nearest town or city street address of well if located within city?

2 - N 1 E of Augusta
2 WATER WELL OWNER: Ken CoKely Kan 67039
RR#, St. Address, Box #: P3 Box 7 Douglas Board of Agriculture, Division of Water Resources
City, State, ZIP Code: Application Number:

3 LOCATE WELL'S LOCATION WITH AN "X" IN SECTION BOX: 4 DEPTH OF COMPLETED WELL... 125 ft. ELEVATION: 100

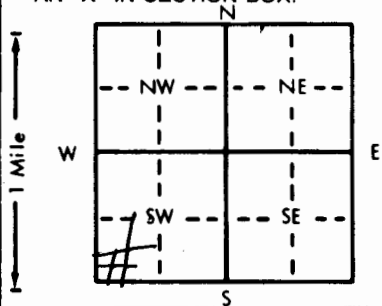

Depth(s) Groundwater Encountered 1. 100 ft. 2. _____ ft. 3. _____ ft.

WELL'S STATIC WATER LEVEL 50 ft. below land surface measured on mo/day/yr _____

Pump test data: Well water was _____ ft. after _____ hours pumping _____ gpm

Est. Yield 10 gpm Well water was _____ ft. after _____ hours pumping _____ gpm

Bore Hole Diameter 8 1/2 in. to _____ ft., and _____ in. to _____ ft.

WELL WATER TO BE USED AS:

5 Public water supply	8 Air conditioning	11 Injection well
① Domestic	6 Oil field water supply	9 Dewatering
2 Irrigation	4 Industrial	7 Lawn and garden only
	10 Monitoring well	12 Other (Specify below) _____

Was a chemical/bacteriological sample submitted to Department? Yes _____ No X; If yes, mo/day/yr sample was submitted _____

Water Well Disinfected? Yes X No _____

5 TYPE OF BLANK CASING USED:	5 Wrought iron	8 Concrete tile	CASING JOINTS: Glued <input checked="" type="checkbox"/> Clamped <input type="checkbox"/>
1 Steel	6 Asbestos-Cement	9 Other (specify below)	Welded <input type="checkbox"/>
2 PVC	7 Fiberglass		Threaded <input type="checkbox"/>
3 RMP (SR)			
4 ABS			

Blank casing diameter 5 in. to 60 ft., Dia in. to ft., Dia in. to ft.
Casing height above land surface 18 in., weight 200 lbs./ft. Wall thickness or gauge No. 12/4

TYPE OF SCREEN OR PERFORATION MATERIAL:			7 PVC	10 Asbestos-cement
1 Steel	3 Stainless steel	5 Fiberglass	8 RMP (SR)	11 Other (specify)
2 Brass	4 Galvanized steel	6 Concrete tile	9 ABS	12 None used (open hole)

SCREEN OR PERFORATION OPENINGS ARE:

1 Continuous slot	3 Mill slot	5 Gauzed wrapped	8 Saw cut	11 None (open hole)
2 Louvered shutter	4 Key punched	6 Wire wrapped	9 Drilled holes	
		7 Torch cut	10 Other (specify)	

SCREEN-PERFORATED INTERVALS: From 60 ft. to 125 ft., From . ft. to . ft.
From . ft. to . ft., From . ft. to . ft.
GRAVEL PACK INTERVALS: From . ft. to . ft., From . ft. to . ft.
From . ft. to . ft. From . ft. to . ft.

6] GROUT MATERIAL: 1 Neat cement 2 Cement grout 3 Bentonite 4 Other
Grout Intervals: From 0 ft. to 20 ft., From ft. to ft., From ft. to ft.

What is the nearest source of possible contamination:

1 Septic tank	4 Lateral lines	7 Pit privy	10 Livestock pens	14 Abandoned water well
2 Sewer lines	5 Cess pool	8 Sewage lagoon	11 Fuel storage	15 Oil well/Gas well
3 Watertight sewer lines	6 Seepage pit	9 Feedyard	12 Fertilizer storage	16 Other (specify below)
Direction from well? <u>N</u>			13 Insecticide storage	
			How many feet? <u>160</u>	

[illegible]

7 CONTRACTOR'S OR LANDOWNER'S CERTIFICATION: This water well was (1) constructed, (2) reconstructed, or (3) plugged under my jurisdiction and was completed on (mo/day/year) 5/19/89 and this record is true to the best of my knowledge and belief. Kansas Water Well Contractor's License No. 2251 This Water Well Record was completed on (mo/day/yr) 6/6/89 under the business name of Winter Well by signature Charles Winter