

1 LOCATION OF WATER WELL:

Fraction

SE $\frac{1}{4}$ NE $\frac{1}{4}$ NE $\frac{1}{4}$

Section Number

12

Township Number

T 27 S

Range Number

R 4 E

County: Butler
Distance and direction from nearest town or city street address of well if located within city?

3 N 2 - E of Augusta

2 WATER WELL OWNER:


Melin Wellener Eldorado Kan 67042
RR#, St: Address, Box # RI Box 104 X

Board of Agriculture, Division of Water Resources

City, State, ZIP Code

Application Number:

3 LOCATE WELL'S LOCATION WITH AN "X" IN SECTION BOX:

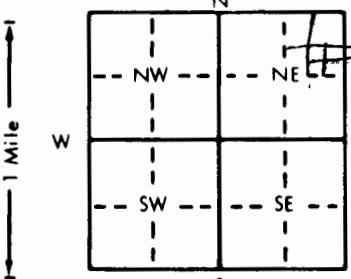

4 DEPTH OF COMPLETED WELL: 125 ft. ELEVATION:

Depth(s) Groundwater Encountered 1. 700 ft. 2. ft. 3. ft.

WELL'S STATIC WATER LEVEL 55 ft. below land surface measured on mo/day/yr

Pump test data: Well water was ft. after hours pumping gpm

Est. Yield 15 gpm Well water was ft. after hours pumping gpm

Bore Hole Diameter 8 1/2 in. to ft., and in. to ft.

WELL WATER TO BE USED AS: 5 Public water supply 8 Air conditioning 11 Injection well

1 Domestic 3 Feedlot 6 Oil field water supply 9 Dewatering 12 Other (Specify below)

2 Irrigation 4 Industrial 7 Lawn and garden only 10 Monitoring well

Was a chemical/bacteriological sample submitted to Department? Yes No If yes, mo/day/yr sample was submitted

Water Well Disinfected? Yes X No

5 TYPE OF BLANK CASING USED:

1 Steel 3 RMP (SR)
 2 PVC 4 ABS

Blank casing diameter 5 in. to 50 ft., Dia in. to ft., Dia in. to ft.

Casing height above land surface 18 in., weight 160 lbs./ft. Wall thickness or gauge No. 214

TYPE OF SCREEN OR PERFORATION MATERIAL:

1 Steel 3 Stainless steel 5 Fiberglass 8 RMP (SR)
 2 Brass 4 Galvanized steel 6 Concrete tile 9 ABS

SCREEN OR PERFORATION OPENINGS ARE:

1 Continuous slot 3 Mill slot 5 Gauzed wrapped 8 Saw cut 11 None (open hole)
 2 Louvered shutter 4 Key punched 6 Wire wrapped 9 Drilled holes
 7 Torch cut 10 Other (specify)

SCREEN-PERFORATED INTERVALS: From 50 ft. to 125 ft., From ft. to ft.

From ft. to ft., From ft. to ft., From ft. to ft.

GRAVEL PACK INTERVALS: From ft. to ft., From ft. to ft., From ft. to ft.

From ft. to ft., From ft. to ft., From ft. to ft.

6 GROUT MATERIAL: 1 Neat cement 2 Cement grout 3 Bentonite 4 Other

Grout Intervals: From 0 ft. to 20 ft., From ft. to ft., From ft. to ft.

What is the nearest source of possible contamination:

1 Septic tank 4 Lateral lines 7 Pit privy
 2 Sewer lines 5 Cess pool 8 Sewage lagoon
 3 Watertight sewer lines 6 Seepage pit 9 Feedyard

10 Livestock pens 14 Abandoned water well
 11 Fuel storage 15 Oil well/Gas well
 12 Fertilizer storage 16 Other (specify below)
 13 Insecticide storage

Direction from well? 5 - W How many feet? 150

7 CONTRACTOR'S OR LANDOWNER'S CERTIFICATION: This water well was (1) constructed, (2) reconstructed, or (3) plugged under my jurisdiction and was completed on (mo/day/year) 6/20/93 and this record is true to the best of my knowledge and belief, Kansas

Water Well Contractor's License No. 251 This Water Well Record was completed on (mo/day/yr) 6/24/92 by (signature) Charles Wellener
 under the business name of Winter Well Drill