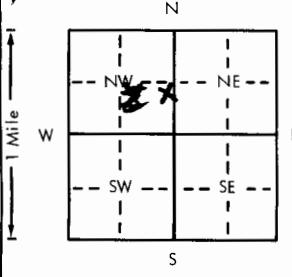
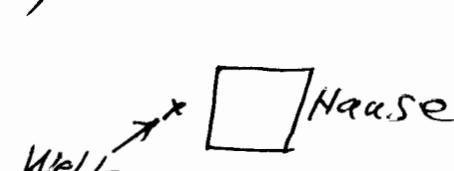


USE TYPEWRITER OR BALL
POINT PEN-PRESS FIRMLY,
PRINT CLEARLY.

WATER WELL RECORD
KSA 82a-1201-1215

Kansas Department of Health and
Environment-Division of Environment
(Water well Contractors)
Topeka, Kansas 66620

1. Location of well: <i>Butler</i>	County <i>NE 1/4 SE 1/4 NW 1/4</i>	Section number <i>14</i>	Township number <i>27</i>	Range number <i>4</i>	
2. Distance and direction from nearest town or city: <i>NE Augusta City</i>	3. Owner of well: <i>Keith Riffel</i>				
Street address of well location if in city: <i>2304 24th</i>	R.R. or street: <i>City</i>	City, state, zip code: <i>Augusta Kan 67010</i>			
4. Locate with "X" in section below: 	Sketch map: 	6. Bore hole dia. <u>8</u> in. Completion date <u>7/17/78</u> Well depth <u>100</u> ft.			
7. <input checked="" type="checkbox"/> Cable tool <input type="checkbox"/> Rotary <input type="checkbox"/> Driven <input type="checkbox"/> Dug <input type="checkbox"/> Hollow rod <input type="checkbox"/> Jetted <input type="checkbox"/> Bored <input type="checkbox"/> Reverse rotary					
8. Use: <input checked="" type="checkbox"/> Domestic <input type="checkbox"/> Public supply <input type="checkbox"/> Industry <input checked="" type="checkbox"/> Irrigation <input type="checkbox"/> Air conditioning <input type="checkbox"/> Stock <input type="checkbox"/> Lawn <input type="checkbox"/> Oil field water <input type="checkbox"/> Other					
9. Casing: Material <u>PLS</u> Height: Above or below Threaded <input type="checkbox"/> Welded <u>C14</u> Surface <u>18</u> in. RMP <input type="checkbox"/> PVC <input type="checkbox"/> Weight <u>100</u> lbs./ft. Dia. <u>6</u> in. to <u>100</u> ft. depth Wall thickness <u>1.75</u> inches or Dia. <u>6</u> in. to <u>100</u> ft. depth Gage No. <u>1.75</u>					
10. Screen: Manufacturer's name <u>Superflow</u> <u>PLASTIC</u> Type <u>100</u> Dia. <u>6</u> Slot/gauze <u>1/16</u> Length <u>20</u> Set between <u>16</u> ft. and <u>80</u> ft. ft. and <u>80</u> ft. Gravel pack? <u>No</u> Size range of material _____					
11. Static water level: <u>40</u> ft. below land surface Date <u>7/19/78</u>					
12. Pumping level below land surfaces: <u>45</u> ft. after <u>1</u> hrs. pumping <u>50</u> g.p.m. ft. after _____ hrs. pumping _____ g.p.m. Estimated maximum yield <u>50</u> g.p.m.					
13. Water sample submitted: _____ mo./day/yr. Yes <input checked="" type="checkbox"/> No Date _____					
14. Well head completion: <input type="checkbox"/> Pitless adapter _____ Inches above grade <input checked="" type="checkbox"/> Well grouted? <u>Yes</u> With: <input checked="" type="checkbox"/> Neat cement <input type="checkbox"/> Bentonite <input type="checkbox"/> Concrete Depth: From <u>6</u> ft. to <u>13</u> ft.					
15. Nearest source of possible contamination: <u>None</u> ft. _____ Direction _____ Type _____					
16. Well disinfected upon completion? Yes <input type="checkbox"/> No _____					
17. Pump: <input checked="" type="checkbox"/> Not installed Manufacturer's name _____ Model number _____ HP _____ Volts _____ Length of drop pipe _____ ft. capacity _____ g.p.m. Type: <input type="checkbox"/> Submersible <input type="checkbox"/> Turbine <input type="checkbox"/> Jet <input type="checkbox"/> Reciprocating <input type="checkbox"/> Centrifugal <input type="checkbox"/> Other					
18. Elevation: Topography: <input type="checkbox"/> Hill <input type="checkbox"/> Slope <input checked="" type="checkbox"/> Upland <input type="checkbox"/> Valley					19. Remarks: (Use a second sheet if needed)
					20. Water well contractor's certification: This well was drilled under my jurisdiction and this report is true to the best of my knowledge and belief. <i>Winter Well Drilling 25th</i> Business name _____ License No. _____ Address _____ Signed <i>Mark W. Winter</i> Date _____ Authorized representative <i>Mark W. Winter</i> Date <u>10/8/78</u>

Forward the white, blue and pink copies to the Department of Health and Environment