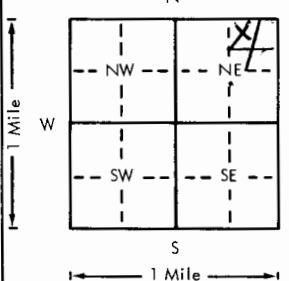
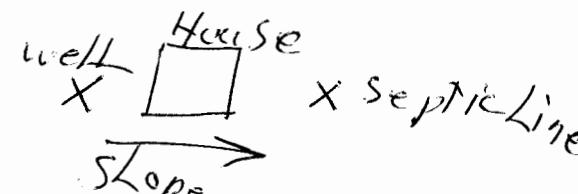


USE TYPEWRITER OR BALL
POINT PEN-PRESS FIRMLY,
PRINT CLEARLY.

WATER WELL RECORD
KSA 82a-1201-1215

Kansas Department of Health and
Environment-Division of Environment
(Water well Contractors)
Topeka, Kansas 66620

1. Location of well:	County <i>Buchler</i>	Fraction <i>NW 1/4 NE 1/4 NE 1/4</i>	Section number <i>14</i>	Township number <i>T 27</i>	Range number <i>S R 4</i>																		
2. Distance and direction from nearest town or city:	<i>Augusta</i>		3. Owner of well: R.R. or street: City, state, zip code:	<i>BILL MARK</i> <i>2530 Ledge</i> <i>Augusta Kan 66016</i>																			
4. Locate with "X" in section below:	Sketch map:		6. Bore hole dia. <u>8</u> in. Completion date <u>8/11/78</u> Well depth <u>100</u> ft.																				
				7. <input checked="" type="checkbox"/> Cable tool <input type="checkbox"/> Rotary <input type="checkbox"/> Driven <input type="checkbox"/> Dug <input type="checkbox"/> Hollow rod <input type="checkbox"/> Jetted <input type="checkbox"/> Bored <input type="checkbox"/> Reverse rotary																			
5. Type and color of material	From	To	8. Use: <input checked="" type="checkbox"/> Domestic <input type="checkbox"/> Public supply <input type="checkbox"/> Industry <input type="checkbox"/> Irrigation <input type="checkbox"/> Air conditioning <input type="checkbox"/> Stock <input type="checkbox"/> Lawn <input type="checkbox"/> Oil field water <input type="checkbox"/> Other																				
<table border="1"> <tr><td>Soil</td><td>0</td><td>5</td></tr> <tr><td>Rock</td><td>5</td><td>25</td></tr> <tr><td>Clay</td><td>25</td><td>35</td></tr> <tr><td>Shale</td><td>35</td><td>55</td></tr> <tr><td>Shale & Lime</td><td>55</td><td>75</td></tr> <tr><td>Water at 80' Lime</td><td>75</td><td>100</td></tr> </table>			Soil	0	5	Rock	5	25	Clay	25	35	Shale	35	55	Shale & Lime	55	75	Water at 80' Lime	75	100	9. Casing: Material <u>PVC</u> Height: Above or below Threaded <input type="checkbox"/> Welded <u>Surface</u> <u>18</u> in. RMP <u>100</u> PVC Weight <u>100</u> lbs./ft. Dig. <u>5</u> in. to <u>100</u> ft. depth Wall Thickness: inches or Dia. <u>5</u> in. to <u>100</u> ft. depth Gage No. <u>115</u>		
			10. Screen: Manufacturer's name <u>SGN FLOW</u>																				
			Type <u>100</u> Dia. <u>5</u> Slot/gauze <u>1/16</u> Length <u>20</u> Set between <u>3.5</u> ft. and <u>9.5</u> ft. ft. and _____ ft. Gravel pack? <u>None</u> Size range of material _____																				
			11. Static water level: <u>45</u> ft. below land surface Date <u>8/9/78</u>																				
			12. Pumping level below land surfaces: <u>50</u> ft. after <u>1</u> hrs. pumping <u>g.p.m.</u> <u>50</u> ft. after <u>hrs.</u> pumping <u>g.p.m.</u> Estimated maximum yield <u>25</u> g.p.m.																				
			13. Water sample submitted: <u>mo./day/yr.</u> Yes <input checked="" type="checkbox"/> No <input type="checkbox"/> Date _____																				
			14. Well head completion: <input type="checkbox"/> Pitless adapter <u>inches above grade</u>																				
			15. Well grouted? <u>Yes</u> With: <input type="checkbox"/> Neat cement <input type="checkbox"/> Bentonite <input checked="" type="checkbox"/> Concrete Depth: From <u>0</u> ft. to <u>10</u> ft.																				
			16. Nearest source of possible contamination: <u>150</u> ft. <u>W</u> <u>Septic</u> Well disinfected upon completion? <input checked="" type="checkbox"/> Yes <input type="checkbox"/> No																				
			17. Pump: <input checked="" type="checkbox"/> Not installed Manufacturer's name _____ Model number _____ HP _____ Volts _____ Length of drop pipe _____ ft. capacity _____ g.p.m. Type: <input type="checkbox"/> Submersible <input type="checkbox"/> Turbine <input type="checkbox"/> Jet <input type="checkbox"/> Reciprocating <input type="checkbox"/> Centrifugal <input type="checkbox"/> Other																				
(Use a second sheet if needed)			20. Water well contractor's certification: This well was drilled under my jurisdiction and this report is true to the best of my knowledge and belief. <i>Winterwell Drilling</i> Business name <u>Winterwell Drilling</u> License No. <u>25</u> Address <u>Augusta Kan</u> Signed <u>Winterwell Drilling</u> Date <u>3/1/88</u> Authorized representative <u>Winterwell Drilling</u>																				
18. Elevation:	19. Remarks:																						
Topography: <input type="checkbox"/> Hill <input type="checkbox"/> Slope <input checked="" type="checkbox"/> Upland <input type="checkbox"/> Valley																							

Forward the white, blue and pink copies to the Department of Health and Environment

Form WWC-5