

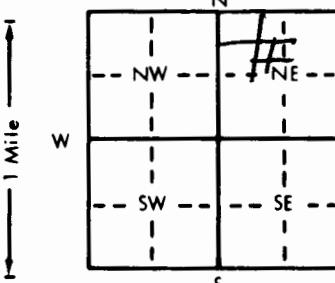
1 LOCATION OF WATER WELL:	Fraction County: Butler	SE $\frac{1}{4}$ NW $\frac{1}{4}$ NE $\frac{1}{4}$	Section Number 14	Township Number T 27 S	Range Number R 40 E/W
---------------------------	-----------------------------------	--	----------------------	---------------------------	--------------------------

Distance and direction from nearest town or city street address of well if located within city?

Central OHIO

2 WATER WELL OWNER:	Terry Knebler	67010	Board of Agriculture, Division of Water Resources
RR#, St. Address, Box #	Box 429 Augusta Kan		
City, State, ZIP Code	Application Number:		

3 LOCATE WELL'S LOCATION WITH AN "X" IN SECTION BOX:	4 DEPTH OF COMPLETED WELL	ft. ELEVATION:
--	---------------------------	----------------

Depth(s) Groundwater Encountered 1. **35** ft. 2. ft. 3. ft.WELL'S STATIC WATER LEVEL **15** ft. below land surface measured on mo/day/yr

Pump test data: Well water was ft. after hours pumping gpm

Est. Yield **50** gpm; Well water was ft. after hours pumping gpmBore Hole Diameter **8.5** in. to ft., and in. to ft.

WELL WATER TO BE USED AS: 5 Public water supply 8 Air conditioning 11 Injection well

1 Domestic 3 Feedlot 6 Oil field water supply 9 Dewatering 12 Other (Specify below)

2 Irrigation 4 Industrial 7 Lawn and garden only 10 Monitoring well

Was a chemical/bacteriological sample submitted to Department? Yes No If yes, mo/day/yr sample was submittedWater Well Disinfected? Yes No

5 TYPE OF BLANK CASING USED:	5 Wrought iron	8 Concrete tile	CASING JOINTS: Glued <input checked="" type="checkbox"/> Clamped <input type="checkbox"/>
------------------------------	----------------	-----------------	---

1 Steel 3 RMP (SR)

2 PVC 4 ABS

Blank casing diameter **5** in. to **30** ft., Dia in. to ft., Dia in. to ft.Casing height above land surface **18** in., weight **160** lbs./ft. Wall thickness or gauge No. **1214**

TYPE OF SCREEN OR PERFORATION MATERIAL:

1 Steel 3 Stainless steel

2 Brass 4 Galvanized steel

5 Fiberglass

6 Asbestos-Cement

7 Fiberglass

8 RMP (SR)

9 Other (specify below)

10 Asbestos-cement

11 Other (specify)

12 None used (open hole)

SCREEN OR PERFORATION OPENINGS ARE:

1 Continuous slot 3 Mill slot

2 Louvered shutter 4 Key punched

5 Gauzed wrapped

6 Wire wrapped

7 Torch cut

8 Saw cut

9 Drilled holes

10 Other (specify)

11 None (open hole)

SCREEN-PERFORATED INTERVALS: From: 30 ft. to 82 ft., From: ft. to ft., From: ft. to ft.

From: ft. to ft., From: ft. to ft., From: ft. to ft.

GRAVEL PACK INTERVALS: From: ft. to ft., From: ft. to ft., From: ft. to ft.

From: ft. to ft., From: ft. to ft., From: ft. to ft.

6 GROUT MATERIAL: 1 Neat cement 2 Cement grout 3 Bentonite 4 Other
--

Grout Intervals: From **0** ft. to **20** ft., From ft. to ft., From ft. to ft., From ft. to ft.

What is the nearest source of possible contamination:

1 Septic tank 4 Lateral lines

2 Sewer lines 5 Cess pool

3 Watertight sewer lines 6 Seepage pit

7 Pit privy

8 Sewage lagoon

9 Feedyard

10 Livestock pens

11 Fuel storage

12 Fertilizer storage

13 Insecticide storage

14 Abandoned water well

15 Oil well/Gas well

16 Other (specify below)

Direction from well?

N - WHow many feet? **200**

FROM	TO	LITHOLOGIC LOG	FROM	TO	PLUGGING INTERVALS
------	----	----------------	------	----	--------------------

0	3	SOIL	FROM	TO	PLUGGING INTERVALS
---	---	-------------	------	----	--------------------

3	10	CLAY	FROM	TO	PLUGGING INTERVALS
---	----	-------------	------	----	--------------------

10	62	SHALE & LIME	FROM	TO	PLUGGING INTERVALS
----	----	-------------------------	------	----	--------------------

7 CONTRACTOR'S OR LANDOWNER'S CERTIFICATION: This water well was (1) constructed, (2) reconstructed, or (3) plugged under my jurisdiction and was completed on (mo/day/year) 5/16/91 and this record is true to the best of my knowledge and belief. Kansas
--

and this record is true to the best of my knowledge and belief. Kansas

Water Well Contractor's License No. **12254** This Water Well Record was completed on (mo/day/yr) **5/21/91** by (signature) **Winter Well Drill**