

1 LOCATION OF WATER WELL:

Fraction

NE $\frac{1}{4}$ SE $\frac{1}{4}$ NW $\frac{1}{4}$

Section Number

Township Number

Range Number

County: Butler

T 27

R 4 E

Distance and direction from nearest town or city street address of well if located within city?

IN City of Augusta

2 WATER WELL OWNER:

Tubby Knebler

RR#, St. Address, Box #:

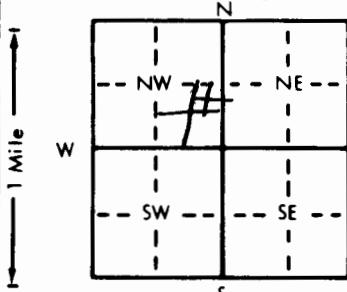
R1 Augusta KS

67010

Board of Agriculture, Division of Water Resources

Application Number:

3 LOCATE WELL'S LOCATION WITH AN "X" IN SECTION BOX:

4 DEPTH OF COMPLETED WELL: 85 ft. ELEVATION:Depth(s) Groundwater Encountered 1. 55 ft. 2. ft. 3. ft.WELL'S STATIC WATER LEVEL: 20 ft. below land surface measured on mo/day/yr

Pump test data: Well water was ft. after hours pumping gpm

Est. Yield 30 gpm; Well water was ft. after hours pumping gpmBore Hole Diameter 8 in. to ft., and in. to ft.

WELL WATER TO BE USED AS: 5 Public water supply 8 Air conditioning 11 Injection well

1 Domestic 3 Feedlot 6 Oil field water supply 9 Dewatering 12 Other (Specify below)

2 Irrigation 4 Industrial 7 Lawn and garden only 10 Monitoring well

Was a chemical/bacteriological sample submitted to Department? Yes No If yes, mo/day/yr sample was submittedWater Well Disinfected? Yes No

5 TYPE OF BLANK CASING USED:

1 Steel 3 RMP (SR)
 2 PVC 4 ABS

5 Wrought iron

8 Concrete tile

CASING JOINTS: Glued Clamped

6 Asbestos-Cement

9 Other (specify below)

Welded

7 Fiberglass

Threaded

Blank casing diameter 5 in. to 40 ft., Dia in. to ft., Dia in. to ft.Casing height above land surface 18 in., weight 160 lbs./ft. Wall thickness or gauge No. 12.14

TYPE OF SCREEN OR PERFORATION MATERIAL:

1 Steel 3 Stainless steel
2 Brass 4 Galvanized steel

5 Fiberglass

8 RMP (SR)

10 Asbestos-cement

6 Concrete tile

9 ABS

11 Other (specify)

12 None used (open hole)

SCREEN OR PERFORATION OPENINGS ARE:

1 Continuous slot 3 Mill slot
2 Louvered shutter 4 Key punched

5 Gauzed wrapped

6 Wire wrapped

11 None (open hole)

7 Torch cut

85

8 Saw cut

9 Drilled holes

10 Other (specify)

SCREEN-PERFORATED INTERVALS: From 40 ft. to 85 ft., From ft. to ft.

From ft. to ft., From ft. to ft. ft. to ft.

GRAVEL PACK INTERVALS: From ft. to ft., From ft. to ft. ft. to ft.

From ft. to ft., From ft. to ft. ft. to ft.

6 GROUT MATERIAL: 1 Neat cement 2 Cement grout 3 Bentonite 4 OtherGrout Intervals: From 0 ft. to 200 ft., From ft. to ft., From ft. to ft.

What is the nearest source of possible contamination:

1 Septic tank 4 Lateral lines
2 Sewer lines 5 Cess pool
 3 Watertight sewer lines 6 Seepage pit

7 Pit privy

8 Sewage lagoon

9 Feedyard

10 Livestock pens

11 Fuel storage

12 Fertilizer storage

13 Insecticide storage

14 Abandoned water well

15 Oil well/Gas well

16 Other (specify below)

Direction from well?

W -

How many feet? 2507 CONTRACTOR'S OR LANDOWNER'S CERTIFICATION: This water well was constructed, (2) reconstructed, or (3) plugged under my jurisdiction and was completed on (mo/day/year) 6/5/92 and this record is true to the best of my knowledge and belief. KansasWater Well Contractor's License No. 251 This Water Well Record was completed on (mo/day/year) 6/30/93 by (signature) Charles Winterunder the business name of Winter Well Drill