

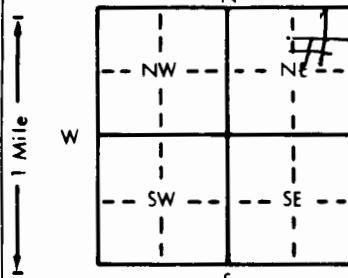
1 LOCATION OF WATER WELL: County: <i>Butler</i>	Fraction: <i>SW 1/4 NE 1/4 NE 1/4</i>	Section Number: <i>14</i>	Township Number: <i>T 27 S</i>	Range Number: <i>R 8 EW</i>
--	---------------------------------------	---------------------------	--------------------------------	-----------------------------

Distance and direction from nearest town or city street address of well if located within city?

*IN Augusta*2 WATER WELL OWNER: *BILL Hulse*

RR#, St. Address, Box #:

City, State, ZIP Code:

Board of Agriculture, Division of Water Resources  
Application Number:3 LOCATE WELL'S LOCATION WITH AN "X" IN SECTION BOX:  
4 DEPTH OF COMPLETED WELL: *106* ft. ELEVATION: *69010*Depth(s) Groundwater Encountered: *1.80* ft. 2. ft. 3. ft.WELL'S STATIC WATER LEVEL: *35* ft. below land surface measured on mo/day/yr

Pump test data: Well water was ft. after hours pumping gpm

Est. Yield: *30* gpm: Well water was ft. after hours pumping gpmBore Hole Diameter: *9* in. to ft. and in. to ft.

WELL WATER TO BE USED AS: 5 Public water supply 8 Air conditioning 11 Injection well

1 Domestic 3 Feedlot 6 Oil field water supply 9 Dewatering 12 Other (Specify below)

2 Irrigation 4 Industrial 7 Lawn and garden only 10 Monitoring well

Was a chemical/bacteriological sample submitted to Department? Yes  No  If yes, mo/day/yr sample was submittedWater Well Disinfected? Yes  No 5 TYPE OF BLANK CASING USED: 5 Wrought iron 8 Concrete tile CASING JOINTS: Glued  Clamped 

1 Steel 3 RMP (SR)

2 PVC 4 ABS

6 Asbestos-Cement

7 Fiberglass

9 Other (specify below)

Welded Threaded Blank casing diameter: *5* in. to *45* ft., Dia. in. to ft., Dia. in. to ft.Casing height above land surface: *18* in., weight: *160* lbs./ft. Wall thickness or gauge No. *12.14*

TYPE OF SCREEN OR PERFORATION MATERIAL:

1 Steel 3 Stainless steel

2 Brass 4 Galvanized steel

5 Fiberglass

6 Concrete tile

7 PVC

8 RMP (SR)

9 ABS

10 Asbestos-cement

11 Other (specify)

12 None used (open hole)

11 None (open hole)

SCREEN OR PERFORATION OPENINGS ARE:

1 Continuous slot 3 Mill slot

2 Louvered shutter 4 Key punched

5 Gauzed wrapped

6 Wire wrapped

7 Torch cut

8 Saw cut

9 Drilled holes

10 Other (specify)

SCREEN-PERFORATED INTERVALS: From: *45* ft. to *106* ft., From: ft. to ft., From: ft. to ft.

GRAVEL PACK INTERVALS: From: ft. to ft., From: ft. to ft., From: ft. to ft.

From: ft. to ft., From: ft. to ft., From: ft. to ft.

6 GROUT MATERIAL: 1 Neat cement 2 Cement grout 3 Bentonite 4 Other

Grout Intervals: From: *3* ft. to *23* ft., From: ft. to ft., From: ft. to ft., From: ft. to ft.

What is the nearest source of possible contamination: 10 Livestock pens 14 Abandoned water well

1 Septic tank 4 Lateral lines

2 Sewer lines 5 Cess pool

3 Watertight sewer lines 6 Seepage pit

7 Pit privy

8 Sewage lagoon

9 Feedyard

11 Fuel storage

12 Fertilizer storage

13 Insecticide storage

15 Oil well/Gas well

16 Other (specify below)

Direction from well?

How many feet? *100*

FROM TO LITHOLOGIC LOG FROM TO PLUGGING INTERVALS

*9 3 Soil**3 10 Clay**10 20 Rock**20 106 Shale & Lime*7 CONTRACTOR'S OR LANDOWNER'S CERTIFICATION: This water well was  constructed,  reconstructed, or  plugged under my jurisdiction and was completed on (mo/day/year) *11/23/92* and this record is true to the best of my knowledge and belief. KansasWater Well Contractor's License No. *237* This Water Well Record was completed on (mo/day/year) *12/8/92* by (signature) *Charles Winter*under the business name of *Winter Well Drill* by (signature) *Charles Winter*

INSTRUCTIONS: Use typewriter or ball point pen. PLEASE PRESS FIRMLY and PRINT clearly. Please fill in blanks, underline or circle the correct answers. Send top three copies to Kansas Department of Health and Environment, Bureau of Water, Topeka, Kansas 66620-0001. Telephone: 913-296-5545. Send one to WATER WELL OWNER and retain one for your records.