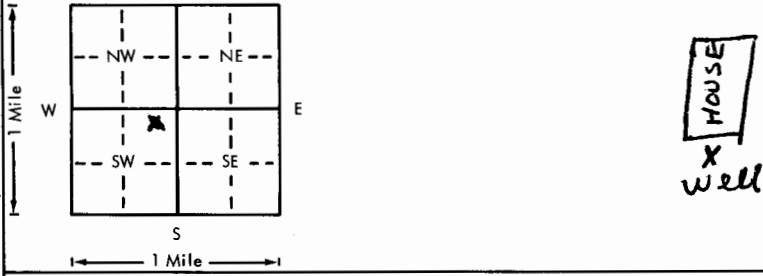


USE TYPEWRITER OR BALL
POINT PEN-PRESS FIRMLY,
PRINT CLEARLY.

WATER WELL RECORD
KSA 82a-1201-1215

Kansas Department of Health and
Environment-Division of Environment
(Water well Contractors)
Topeka, Kansas 66620

1. Location of well:	County Butler	Fraction NE 1/4 NE 1/4 SW 1/4	Section number 15	Township number T 27 S R 4 E W	Range number 4
2. Distance and direction from nearest town or city: In the city of Augusta			3. Owner of well: Lloyd Loomis R.R. or street: 406 North Pershing Ave City, state, zip code: Wichita Kans		
4. Locate with "X" in section below: N W E S 1 Mile 1 Mile			Sketch map: 		
5. Type and color of material			6. Bore hole dia. 10 in. Completion date 8-1-1978 Well depth 125 ft.		
			7. <input checked="" type="checkbox"/> Cable tool <input type="checkbox"/> Rotary <input type="checkbox"/> Driven <input type="checkbox"/> Dug <input type="checkbox"/> Hollow rod <input type="checkbox"/> Jetted <input type="checkbox"/> Bored <input type="checkbox"/> Reverse rotary		
			8. Use: <input type="checkbox"/> Domestic <input type="checkbox"/> Public supply <input type="checkbox"/> Industry <input type="checkbox"/> Irrigation <input type="checkbox"/> Air conditioning <input type="checkbox"/> Stock <input checked="" type="checkbox"/> Lawn <input type="checkbox"/> Oil field water <input type="checkbox"/> Other		
			9. Casing: Material plb Height: Above or below Threaded <input type="checkbox"/> Welded <input type="checkbox"/> Surface 12 in. RMP <input checked="" type="checkbox"/> PVC <input type="checkbox"/> Weight <input type="checkbox"/> lbs./ft. Dia. 6 in. to 20 ft. depth Wall Thickness: inches or Dia. 6 in. to 100 ft. depth gage No. 125		
			10. Screen: Manufacturer's name J & R Type RMP Dia. 6 in Slot gauge 1/4 in Length 40 ft Set between 20 ft. and 40 ft. Gravel pack? no Size range of material		
			11. Static water level: 17 ft. below land surface Date 8-1-1978 mo./day/yr.		
			12. Pumping level below land surfaces: ____ ft. after ____ hrs. pumping ____ g.p.m. ____ ft. after ____ hrs. pumping ____ g.p.m. Estimated maximum yield 8 g.p.m.		
			13. Water sample submitted: X Yes <input type="checkbox"/> No Date ____ mo./day/yr.		
			14. Well head completion: <input checked="" type="checkbox"/> Pitless adapter 12 inches above grade		
			15. Well grouted? yes With: <input checked="" type="checkbox"/> Neat cement <input type="checkbox"/> Bentonite <input type="checkbox"/> Concrete Depth: From 3 ft. to 13 ft.		
			16. Nearest source of possible contamination: ft. ____ Direction ____ Type ____ Well disinfected upon completion? <input type="checkbox"/> Yes <input checked="" type="checkbox"/> No		
			17. Pump: <input type="checkbox"/> Not installed Manufacturer's name Waukegan Model number 7EH HP 1/2 Volts 230 Length of drop pipe 115 ft. capacity 7 g.p.m. Type: <input checked="" type="checkbox"/> Submersible <input type="checkbox"/> Turbine <input type="checkbox"/> Jet <input type="checkbox"/> Reciprocating <input type="checkbox"/> Centrifugal <input type="checkbox"/> Other		
18. Elevation:			20. Water well contractor's certification: This well was drilled under my jurisdiction and this report is true to the best of my knowledge and belief. Whe Well Drilling 122 Business name Box 57 Augusta Address Rt 3 Signed M. L. Loomis Date 8-1-1978 Authorized representative		
19. Remarks: owner will put on slab M. L. Loomis					

Forward the white, blue and pink copies to the Department of Health and Environment

Form WWC-5