

1 LOCATION OF WATER WELL:

County: ButlerFraction 1/4 NW 1/4 SW 1/4Section Number 16Township Number T 27 SRange Number R 5 E

Distance and direction from nearest town or city street address of well if located within city?

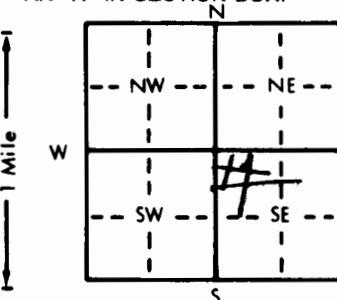
2-W - 2 N of Augusta

2 WATER WELL OWNER:

RR#, St. Address, Box #

City, State, ZIP Code

3 LOCATE WELL'S LOCATION WITH AN "X" IN SECTION BOX:

4 DEPTH OF COMPLETED WELL. 105 ft. ELEVATION:Depth(s) Groundwater Encountered 1 35 ft. 2 ft. 3 ft.WELL'S STATIC WATER LEVEL 35 ft. below land surface measured on mo/day/yr

Pump test data: Well water was ft. after hours pumping gpm

Est. Yield 40 gpm. Well water was ft. after hours pumping gpmBore Hole Diameter 8 in. to ft., and in. to ft.

WELL WATER TO BE USED AS: 5 Public water supply 8 Air conditioning 11 Injection well

1 Domestic 3 Feedlot 6 Oil field water supply 9 Dewatering 12 Other (Specify below)

2 Irrigation 4 Industrial 7 Lawn and garden only 10 Monitoring well

Was a chemical/bacteriological sample submitted to Department? Yes No If yes, mo/day/yr sample was submitted

Water Well Disinfected? Yes No

5 TYPE OF BLANK CASING USED:

1 Steel 3 RMP (SR)
 2 PVC 4 ABS

5 Wrought iron

8 Concrete tile

CASING JOINTS: Glued Clamped

6 Asbestos-Cement

9 Other (specify below)

Welded

7 Fiberglass

Threaded

Blank casing diameter 5 in. to 40 ft., Dia in. to ft., Dia in. to ft.Casing height above land surface 18 in., weight 160 lbs./ft. Wall thickness or gauge No. 12.14

TYPE OF SCREEN OR PERFORATION MATERIAL:

1 Steel 3 Stainless steel
2 Brass 4 Galvanized steel

5 Fiberglass

8 RMP (SR)

10 Asbestos-cement

6 Concrete tile

9 ABS

11 Other (specify)

5 Gauzed wrapped

8 Baw cut

11 None (open hole)

6 Wire wrapped

9 Drilled holes

7 Torch cut

10 Other (specify)

SCREEN OR PERFORATION OPENINGS ARE: From 40 ft. to 105 ft., From ft. to ft.

From ft. to ft., From ft. to ft., From ft. to ft.

GRAVEL PACK INTERVALS: From ft. to ft., From ft. to ft., From ft. to ft.

6 GROUT MATERIAL: 1 Neat cement 2 Cement grout 3 Bentonite 4 OtherGrout Intervals: From 0 ft. to 20 ft., From ft. to ft., From ft. to ft.

What is the nearest source of possible contamination:

1 Septic tank 4 Lateral lines
2 Sewer lines 5 Cess pool
3 Watertight sewer lines 6 Seepage pit7 Pit privy
8 Sewage lagoon
9 Feedyard10 Livestock pens
11 Fuel storage
12 Fertilizer storage
13 Insecticide storage14 Abandoned water well
15 Oil well/Gas well
16 Other (specify below)

Direction from well?

N EHow many feet? 150

FROM TO LITHOLOGIC LOG FROM TO PLUGGING INTERVALS

0 4
4 12
12 105 Sq. shale Clay Shale Lime7 CONTRACTOR'S OR LANDOWNER'S CERTIFICATION: This water well was constructed, (2) reconstructed, or (3) plugged under my jurisdiction and was completed on (mo/day/year) 9/10/92 and this record is true to the best of my knowledge and belief. KansasWater Well Contractor's License No. 251 This Water Well Record was completed on (mo/day/year) 9/30/92 by (signature) Charles Winter under the business name of Winter Well Drill