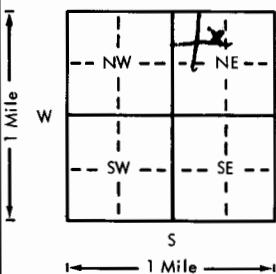
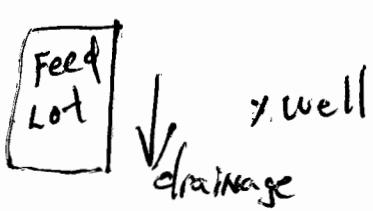


USE TYPEWRITER OR BALL
POINT PEN-PRESS FIRMLY,
PRINT CLEARLY.

WATER WELL RECORD
KSA 82a-1201-1215

Kansas Department of Health and
Environment-Division of Environment
(Water well Contractors)
Topeka, Kansas 66620

1. Location of well:	County	Fraction	Section number	Township number	Range number
30th er		NE 1/4 NW 1/4 NE 1/4	17	T 27	S R 4 E
2. Distance and direction from nearest town or city: Street address of well location if in city:	SW 2N 1/4 W of Augusta		3. Owner of well: R.R. or street: City, state, zip code:	Henry CHINN R#1 Augusta Kansas	
4. Locate with "X" in section below:	Sketch map:		6. Bore hole dia. 8.5 in. Completion date 3-28-77 Well depth 58 ft.		
			<input checked="" type="checkbox"/> Cable tool <input type="checkbox"/> Rotary <input type="checkbox"/> Driven <input type="checkbox"/> Dug <input type="checkbox"/> Hollow rod <input type="checkbox"/> Jetted <input type="checkbox"/> Bored <input type="checkbox"/> Reverse rotary		
5. Type and color of material	From	To	8. Use:	7. Industry Stock Other	
TOPSoil	0	1	<input type="checkbox"/> Domestic <input type="checkbox"/> Public supply <input checked="" type="checkbox"/> Irrigation <input type="checkbox"/> Air conditioning <input type="checkbox"/> Stock <input type="checkbox"/> Lawn <input type="checkbox"/> Oil field water <input type="checkbox"/> Other		
Clay Red	1	20	9. Casing: Material <input type="checkbox"/> PITS <input checked="" type="checkbox"/> PVC Height: Above or below Threaded <input type="checkbox"/> Welded <input checked="" type="checkbox"/> Surface 24 in. RMP <input checked="" type="checkbox"/> PVC Weight lbs./ft. Dia. 5 in. to 58 ft. depth Wall Thickness: inches or Dia. in. to ft. depth gage No. 200		
Sand yellow brown	20	27	10. Screen: Manufacturer's name <input type="checkbox"/> sunflower <input checked="" type="checkbox"/> PITS		
Lime Stone yellow	27	35	Type <input type="checkbox"/> RMP Dia. 5" Slot/gauze <input type="checkbox"/> 34 Length 10' Set between <input type="checkbox"/> 48 ft. and <input type="checkbox"/> 58 ft. ft. and ft.		
Shale gray	35	58	Gravel pack? <input type="checkbox"/> yes Size range of material <input type="checkbox"/> 18 to 24		
(Water at 27')			11. Static water level: 17 ft. below land surface Date 3-28-77		
			12. Pumping level below land surfaces: NA		
			ft. after hrs. pumping g.p.m. ft. after hrs. pumping g.p.m. Estimated maximum yield g.p.m.		
			13. Water sample submitted: mo./day/yr. Yes <input checked="" type="checkbox"/> No Date		
			14. Well head completion: <input type="checkbox"/> Pitless adapter 24 inches above grade		
			15. Well grouted? <input type="checkbox"/> yes With: <input type="checkbox"/> Neat cement <input type="checkbox"/> Bentonite <input checked="" type="checkbox"/> Concrete Depth: From 13 ft. to 3 ft.		
			16. Nearest source of possible contamination: ft. 80 Direction <input type="checkbox"/> West Type <input type="checkbox"/> Feed lot Well disinfected upon completion? <input checked="" type="checkbox"/> Yes <input type="checkbox"/> No		
			17. Pump: <input checked="" type="checkbox"/> Not installed Manufacturer's name _____ Model number _____ HP _____ Volts _____ Length of drop pipe _____ ft. capacity _____ g.p.m. Type: <input type="checkbox"/> Submersible <input type="checkbox"/> Turbine <input type="checkbox"/> Jet <input type="checkbox"/> Reciprocating <input type="checkbox"/> Centrifugal <input type="checkbox"/> Other		
(Use a second sheet if needed)			18. Elevation:	19. Remarks:	
Topography: <input type="checkbox"/> Hill <input checked="" type="checkbox"/> Slope <input type="checkbox"/> Upland <input type="checkbox"/> Valley				20. Water well contractor's certification: This well was drilled under my jurisdiction and this report is true to the best of my knowledge and belief. Business name <input type="checkbox"/> Braddy water wells 363 Address <input type="checkbox"/> 12 Douglass KS Signed <input type="checkbox"/> Richard Braddy Date 3-28-77 Authorized representative	