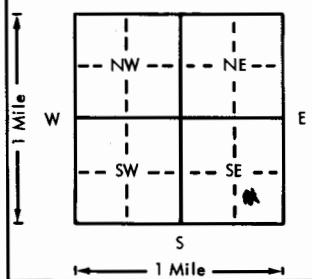


USE TYPEWRITER OR BALL  
POINT PEN-PRESS FIRMLY,  
PRINT CLEARLY.

WATER WELL RECORD  
KSA 82a-1201-1215

Kansas Department of Health and  
Environment-Division of Environment  
(Water well Contractors)  
Topeka, Kansas 66620

1. Location of well:	County <b>Butler</b>	Fraction <b>1/4 SE 1/4 SE 1/4</b>	Section number <b>18</b>	Township number <b>T 27</b>	Range number <b>S R 4 (E)</b>
2. Distance and direction from nearest town or city:	<b>2 W 1 N</b>		3. Owner of well: <b>James Wray</b>		
Street address of well location if in city:	<b>Augusta Kans</b>		R.R. or street: <b>R # 2</b>		
4. Locate with "X" in section below:	Sketch map: 		6. Bore hole dia. <b>10</b> in. Completion date <b>4-21-1978</b> Well depth <b>90</b> ft.		
			7. <input checked="" type="checkbox"/> Cable tool <input type="checkbox"/> Rotary <input type="checkbox"/> Driven <input type="checkbox"/> Dug <input type="checkbox"/> Hollow rod <input type="checkbox"/> Jetted <input type="checkbox"/> Bored <input type="checkbox"/> Reverse rotary		
			8. Use: <input checked="" type="checkbox"/> Domestic <input type="checkbox"/> Public supply <input type="checkbox"/> Industry <input type="checkbox"/> Irrigation <input type="checkbox"/> Air conditioning <input type="checkbox"/> Stock <input type="checkbox"/> Lawn <input type="checkbox"/> Oil field water <input type="checkbox"/> Other		
			9. Casing: Material <b>RMP</b> Height <b>Above or below</b> Threaded <input type="checkbox"/> Welded <b>8</b> Surface <b>71</b> in. RMP <b>X</b> PVC <b>6</b> Weight <b>175</b> lbs./ft. Dia. <b>6</b> in. to <b>70</b> ft. depth Wall Thickness: inches or Dia. <b>6</b> in. to <b>ft.</b> depth gage No. <b>175</b>		
5. Type and color of material	From	To	10. Screen: Manufacturer's name <b>RMP</b> Type <b>RMP</b> Dia. <b>6</b> <b>1/2</b> gauze Length <b>20 ft</b> Set between <b>70</b> ft. and <b>90</b> ft. ft. and <b>ft.</b> Gravel pack? <b>no</b> Size range of material		
	<b>0</b>	<b>7</b>			
	<b>7</b>	<b>21</b>			
	<b>21</b>	<b>43</b>			
	<b>43</b>	<b>54</b>			
	<b>54</b>	<b>78</b>			
	<b>78</b>				
	<b>78</b>	<b>90</b>			
(Use a second sheet if needed)			11. Static water level: <b>45</b> ft. below land surface Date <b>4-21-1978</b>		
			12. Pumping level below land surfaces: ft. after hrs. pumping g.p.m. ft. after hrs. pumping g.p.m. Estimated maximum yield <b>20</b> g.p.m.		
			13. Water sample submitted: Yes <input checked="" type="checkbox"/> No <input type="checkbox"/> Date		
			14. Well head completion: Pitless adapter <b>12</b> Inches above grade		
			15. Well grouted? <b>yes</b> With: <input checked="" type="checkbox"/> Neat cement <input type="checkbox"/> Bentonite <input type="checkbox"/> Concrete Depth: From <b>3</b> ft. to <b>13</b> ft.		
			16. Nearest source of possible contamination: ft. direction Type Well disinfected upon completion? <b>no</b> Yes <input type="checkbox"/> No		
			17. Pump: <b>X</b> Not installed Manufacturer's name Model number <b>HP</b> Volts <b>110</b> Length of drop pipe ft. capacity g.p.m. Type: <input type="checkbox"/> Submersible <b>Turbine</b> <input type="checkbox"/> Jet <b>Reciprocating</b> <input type="checkbox"/> Centrifugal <b>Other</b>		
			18. Elevation: Topography: <input checked="" type="checkbox"/> Hill <input type="checkbox"/> Slope <input type="checkbox"/> Upland <input type="checkbox"/> Valley	19. Remarks: <b>owner will put on slab</b> <b>James E. Wray</b>	
			20. Water well contractor's certification: This well was drilled under my jurisdiction and this report is true to the best of my knowledge and belief. <b>Wise Well Drilling</b> <b>112</b> Business name <b>RH 3 Box 57</b> Address <b>Augusta Kans</b> License No. Signed <b>James E. Wray</b> Date <b>4-21-1978</b> Authorized representative <b>James E. Wray</b> Date <b>4-21-1978</b>		

Forward the white, blue and pink copies to the Department of Health and Environment

Form WWC-5