USE TYPEWRITER OR BALL POINT PEN-PRESS FIRMLY, PRINT CLEARLY.

WATER WELL RECORD
KSA 82a-1201-1215

Kansas Department of Health and Environment-Division of Environment
(Water well Contractors)
Topeka, Kansas 66620

1. Location of well: County: Butler — Fraction: ~~NE~~ SW NW ~~SE 1/4 SW 1/4 SW 1/4~~ — Section number: 18 — Township number: T 27 S — Range number: R 4 E W

2. Distance and direction from nearest town or city: 3 W 2 N Augusta
Street address of well location if in city:

3. Owner of well: Ken Lowrance
R.R. or street: R2 Augusta
City, state, zip code: 67010

4. Locate with "X" in section below:

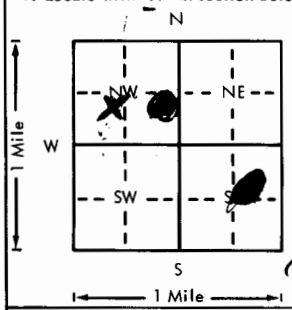

Sketch map:

6. Bore hole dia. 8 in. Completion date 8/10/18
Well depth 20 ft.

7. X Cable tool __ Rotary __ Driven __ Dug
__ Hollow rod __ Jetted __ Bored __ Reverse rotary

8. Use: X Domestic __ Public supply __ Industry
__ Irrigation __ Air conditioning __ Stock
__ Lawn __ Oil field water __ Other

9. Casing: Material plast Height: Above or below
Threaded __ Welded __ Surface 18 in.
RMP X PVC __ Weight 100 lbs./ft.
Dia. 6 in. to 20 ft. depth Wall Thickness: inches or
Dia. __ in. to __ ft. depth gage No. 1175

5. Type and color of material	From	To
Soil Black	0	2
Clay Yellow	2	18
Lime & Shale	18	50
Lime Shale some gravel	50	70

(Use a second sheet if needed)

10. Screen: Manufacturer's name Sea Flower Plastics
Type 100 Dia. 6
Slot/gauze 1/16 Length 20
Set between 30 ft. and 50 ft.
ft. and ft.
Gravel pack? No Size range of material

11. Static water level: 35 ft. below land surface Date 9/6/18 mo./day/yr.

12. Pumping level below land surfaces: 45 ft. after 1 hrs. pumping 20 g.p.m.
ft. after hrs. pumping g.p.m.
Estimated maximum yield g.p.m.

13. Water sample submitted: mo./day/yr.
__ Yes X No Date

14. Well head completion:
X Pitless adapter 18 Inches above grade

15. Well grouted? Yes
With: __ Neat cement __ Bentonite __ Concrete
Depth: From 0 ft. to 10 ft.

16. Nearest source of possible contamination:
ft. 500 Direction S-E Type Septic
Well disinfected upon completion? X Yes __ No

17. Pump: Transfered Not installed
Manufacturer's name
Model number HP Volts
Length of drop pipe 65 ft. capacity g.p.m.
Type:
X Submersible __ Turbine
__ Jet __ Reciprocating
__ Centrifugal __ Other

18. Elevation:
Topography:
__ Hill
__ Slope
X Upland
__ Valley

19. Remarks: Owner to install Concret Slab around Well

20. Water well contractor's certification:
This well was drilled under my jurisdiction and this report is true to the best of my knowledge and belief.
Winter Well Drill 251A
Business name License No.
Address R2 Box 30 Augusta
Signed Charles W. Winter Date 9/15/18
Authorized representative

Forward the white, blue and pink copies to the Department of Health and Environment

Form WWC-5

M1-1023

27 - 4E 18 NESWNW
T R Sec 1/4 1/4 1/4