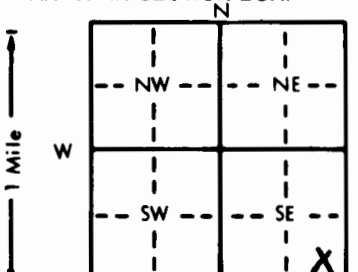


1 LOCATION OF WATER WELL: County: <u>Butler</u>	Fraction <u>SE 1/4</u> <u>SE 1/4</u> <u>SE 1/4</u>	Section Number <u>19</u>	Township Number T <u>27</u> S	Range Number R <u>4</u> E
--	---	-----------------------------	----------------------------------	------------------------------

Distance and direction from nearest town or city street address of well if located within city?

2 mile west, Augusta, KS

2 WATER WELL OWNER: RR#, St. Address, Box # : <u>Steven Ford</u> City, State, ZIP Code : <u>117 W. 6th</u> <u>Augusta, KS 67010</u>	Board of Agriculture, Division of Water Resources Application Number:
--	--

3 LOCATE WELL'S LOCATION WITH AN "X" IN SECTION BOX: 	4 DEPTH OF COMPLETED WELL: <u>95</u> ft. ELEVATION: Depth(s) Groundwater Encountered 1. <u>25</u> ft. 2. <u>87</u> ft. 3. <u>95</u> ft. WELL'S STATIC WATER LEVEL <u>25</u> ft. submitted to Department? Yes <u>✓</u> No <u>✓</u> . If yes, mo/day/yr sample was submitted <u>3/3/23</u> Water Well Disinfected? Yes <u>✓</u> No <u>✓</u>
--	---

5 TYPE OF BLANK CASING USED: 1 Steel <u>✓</u> 3 RMP (SR) 5 Wrought iron 8 Concrete tile 2 Brass 4 ABS 6 Asbestos-Cement 9 Other (specify below) Blank casing diameter <u>5</u> in. to <u>5</u> ft. Dia. <u>1.2</u> in. to <u>1.6</u> in. weight <u>160</u> lbs./ft. Wall thickness or gauge No. <u>160</u> TYPE OF SCREEN OR PERFORATION MATERIAL: 1 Steel 3 Stainless steel 5 Fiberglass 8 RMP (SR) 10 Asbestos-cement 2 Brass 4 Galvanized steel 6 Concrete tile 9 ABS 11 Other (specify) SCREEN OR PERFORATION OPENINGS ARE: 1 Continuous slot 3 Mill slot 5 Gauzed wrapped 8 Saw cut 11 None (open hole) 2 Louvered shutter 4 Key punched 6 Wire wrapped 9 Drilled holes SCREEN-PERFORATED INTERVALS: From <u>75</u> ft. to <u>95</u> ft. From <u>75</u> ft. to <u>95</u> ft. GRAVEL PACK INTERVALS: From <u>20</u> ft. to <u>95</u> ft. From <u>20</u> ft. to <u>95</u> ft.	CASING JOINTS: Glued <u>✓</u> Clamped <u>✓</u> Welded <u>✓</u> Threaded <u>✓</u>
---	--

6 GROUT MATERIAL: 1 Neat cement 2 Cement grout 3 Bentonite 4 Other Grout Intervals: From <u>3</u> ft. to <u>20</u> ft. From <u>3</u> ft. to <u>20</u> ft. What is the nearest source of possible contamination: 1 Septic tank 4 Lateral lines 7 Pit privy 10 Livestock pens 14 Abandoned water well 2 Sewer lines 5 Cess pool 8 Sewage lagoon 11 Fuel storage 15 Oil well/Gas well 3 Watertight sewer lines 6 Seepage pit 9 Feedyard 12 Fertilizer storage 16 Other (specify below) Direction from well? <u>Downslope</u> How many feet? <u>50+</u>

FROM	TO	LITHOLOGIC LOG	FROM	TO	PLUGGING INTERVALS
0	3	DIRT			
3	17	red clay			
17	72	yellow clay			
72	80	gray clay			
80	95	gray shaley lime			

7 CONTRACTOR'S OR LANDOWNER'S CERTIFICATION: This water well was (1) constructed, (2) reconstructed, or (3) plugged under my jurisdiction and was completed on (mo/day/year) <u>3/3/23</u> and this record is true to the best of my knowledge and belief. Kansas Water Well Contractor's License No. <u>3193</u> This Water Well Record was completed on (mo/day/yr) <u>3/3/23</u> under the business name of <u>Reisner Well Drilling</u> by (signature) <u>Reisner</u>
