

1 LOCATION OF WATER WELL		Fraction	Section Number	Township Number	Range Number		
County: BUTLER		SW 1/4 SW 1/4 SW 1/4	20	T 27 S	R 4 EW /		
Distance and direction from nearest town or city? 1 1/2 East of Santa Fe Lake Road, Driveway			Street address of well if located within city? North off of 54 highway, Augusta, Ks.				
2 WATER WELL OWNER: Owen McEwen RR#, St. Address, Box #: 700 East Central City, State, ZIP Code: Wichita, Kansas			Board of Agriculture, Division of Water Resources Application Number:				
3 DEPTH OF COMPLETED WELL 65 ft. Bore Hole Diameter 1.1 in. to ft., and in. to ft.							
Well Water to be used as:							
1 Domestic		3 Feedlot	5 Public water supply	8 Air conditioning	11 Injection well		
2 Irrigation		4 Industrial	6 Oil field water supply	9 Dewatering	12 Other (Specify below)		
		7 Lawn and garden only	10 Observation well	(For Heat Pump)			
Well's static water level 2.8 ft. below land surface measured on 8 month 6 day 1980 year							
Pump Test Data: Well water was ft. after hours pumping gpm							
Est. Yield gpm: Well water was ft. after hours pumping gpm							
4 TYPE OF BLANK CASING USED:							
1 Steel		3 RMP (SR)	5 Wrought iron	8 Concrete tile	Casing Joints: Glued X Clamped		
2 PVC		4 ABS	6 Asbestos-Cement	9 Other (specify below)	Welded		
			7 Fiberglass		Threaded		
Blank casing dia 5 in. to 30 ft., Dia in. to ft., Dia in. to ft.							
Casing height above land surface 1.2 in., weight lbs./ft. Wall thickness or gauge No 200							
TYPE OF SCREEN OR PERFORATION MATERIAL:							
1 Steel		3 Stainless steel	5 Fiberglass	8 RMP (SR)	10 Asbestos-cement		
2 Brass		4 Galvanized steel	6 Concrete tile	9 ABS	11 Other (specify)		
					12 None used (open hole)		
Screen or Perforation Openings Are:							
1 Continuous slot		3 Mill slot	5 Gauzed wrapped	8 Saw cut	11 None (open hole)		
2 Louvered shutter		4 Key punched	6 Wire wrapped	9 Drilled holes			
			7 Torch cut	10 Other (specify)			
Screen-Perforation Dia 5 in. to 6.5 ft., Dia in. to ft., Dia in. to ft.							
Screen-Perforated Intervals: From 30 ft. to 65 ft., From ft. to ft., From ft. to ft.							
Gravel Pack Intervals: From 1.4 ft. to 65 ft., From ft. to ft., From ft. to ft.							
5 GROUT MATERIAL: 1 Neat cement 2 Cement grout 3 Bentonite 4 Other							
Grouted Intervals: From 4.0 ft. to 1.4 ft., From ft. to ft., From ft. to ft.							
What is the nearest source of possible contamination:							
1 Septic tank		4 Cess pool	7 Sewage lagoon	10 Fuel storage	14 Abandoned water well		
2 Sewer lines		5 Seepage pit	8 Feed yard	11 Fertilizer storage	15 Oil well/Gas well		
3 Lateral lines		6 Pit privy	9 Livestock pens	12 Insecticide storage	16 Other (specify below)		
Direction from well South How many feet 200 ? Water Well Disinfected? Yes X No							
Was a chemical/bacteriological sample submitted to Department? Yes No X If yes, date sample was submitted month day year Pump Installed? Yes No X							
If Yes: Pump Manufacturer's name Model No. HP Volts							
Depth of Pump Intake ft. Pumps Capacity rated at gal./min.							
Type of pump: 1 Submersible 2 Turbine 3 Jet 4 Centrifugal 5 Reciprocating 6 Other							
6 CONTRACTOR'S OR LANDOWNER'S CERTIFICATION: This water well was (1) constructed, (2) reconstructed, or (3) plugged under my jurisdiction and was completed on 8 month 6 day 1980 year							
and this record is true to the best of my knowledge and belief. Kansas Water Well Contractor's License No. 236							
This Water Well Record was completed on 1 month 29 day 81 year under the business name of Harp Well & Pump Service, Inc. by (signature) m. Arnold							
7 LOCATE WELL'S LOCATION WITH AN "X" IN SECTION BOX:		FROM	TO	LITHOLOGIC LOG	FROM	TO	LITHOLOGIC LOG
		0	2	Topsoil			
		2	16	Clay			
		16	18	Sandstone			
		18	26	Fractured Rock (sandstone)			
		26	34	Limestone			
		34	56	Gray Shale			
		56	65	Blue Shale			
ELEVATION:							
Depth(s) Groundwater Encountered 1 2.8 ft. 2 ft. 3 ft. 4 ft. (Use a second sheet if needed)							

RECEIVED

FEB 10 1981

DIVISION OF ENVIRONMENT
OF SEC.

INSTRUCTIONS: Use typewriter or ball point pen, please press firmly and PRINT clearly. Please fill in blanks, underline or circle the correct answers. Send top three copies to Kansas Department of Health and Environment, Division of Environment, Water Well Contractors, Topeka, KS 66620. Send one to WATER WELL OWNER and retain one for your records.

PHONE
(316) 722-1411




HARP WELL & PUMP SERVICE, INC.

Water Well Drilling - Piling Hole Drilling - Test Drilling
Gravel Packed Wells for
Home - Industrial - Municipal - Irrigation
PUMP SALES & SERVICE

215 SO. TYLER ROAD

WICHITA, KANSAS 67209

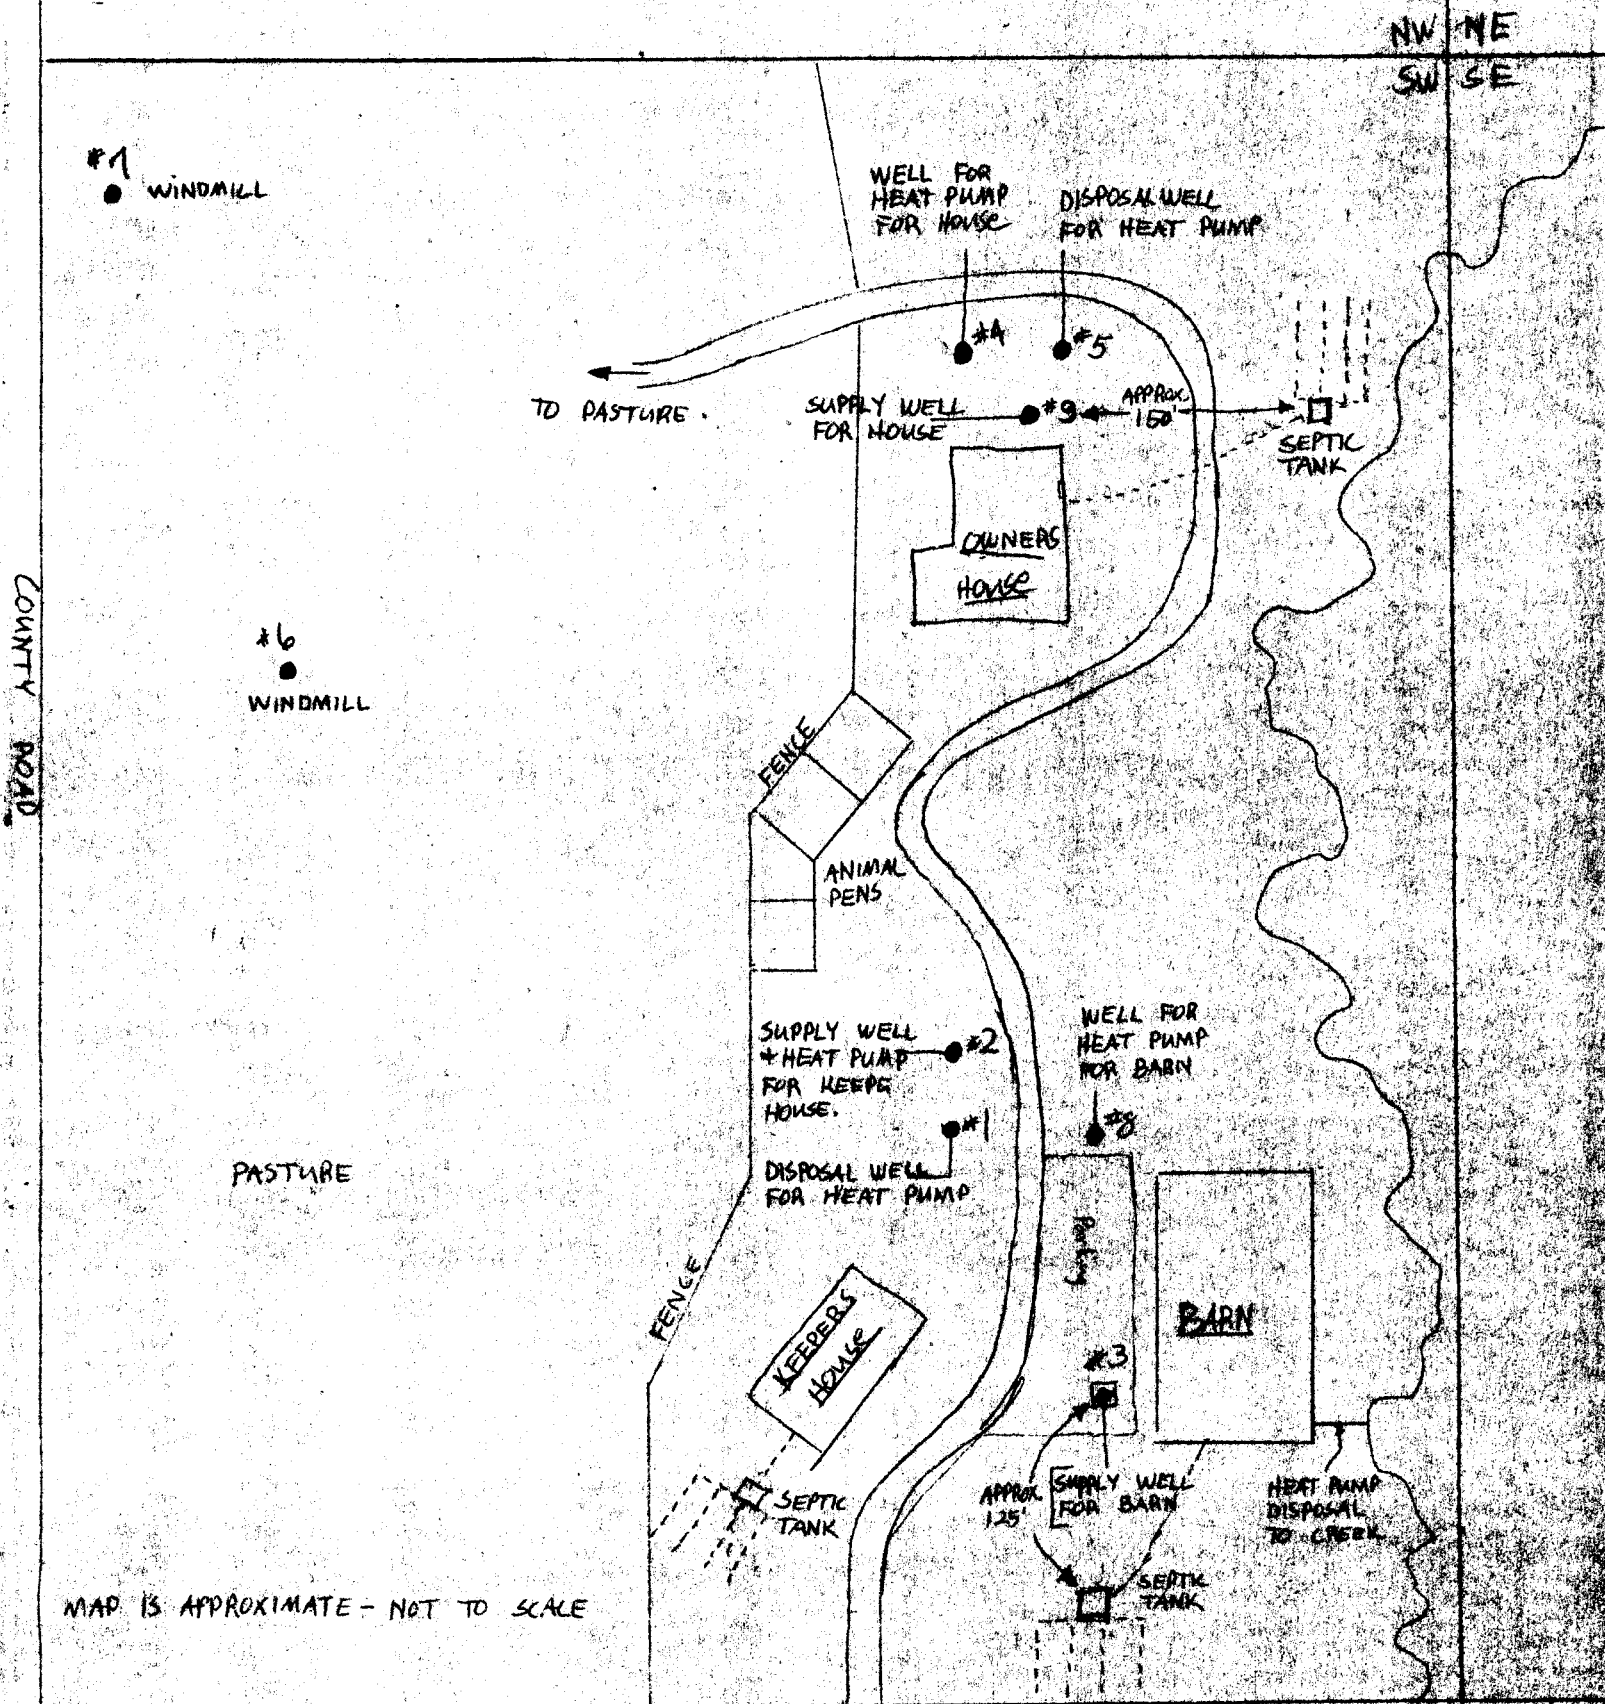

MAP IS APPROXIMATE - NOT TO SCALE