

1 LOCATION OF WATER WELL		Fraction <u>SW SE SW</u>	Section Number	Township Number	Range Number
County: BUTLER		$\frac{1}{4}$ $\frac{1}{4}$ $\frac{1}{4}$	20	T 27 S	R 4 EW //
Distance and direction from nearest town or city? <u>1 1/2 East of Santa Fe Lake Rd., Driveway North off of 54 Hwy, Augusta, Ks.</u>			Street address of well if located within city?		
2 WATER WELL OWNER: Owen McEwen			Board of Agriculture, Division of Water Resources		
RR#, St. Address, Box #: 700 East Central			Application Number:		
City, State, ZIP Code: Wichita, Ks.					
3 DEPTH OF COMPLETED WELL: 65 ft. Bore Hole Diameter: 11 in. to ft. and in. to ft.					
Well Water to be used as:					
1 Domestic 3 Feedlot		5 Public water supply		8 Air conditioning 11 Injection well	
2 Irrigation 4 Industrial		6 Oil field water supply		9 Dewatering 12 Other (Specify below)	
		7 Lawn and garden only		10 Observation well	
Well's static water level: 28 ft. below land surface measured on 12 month 30 day 80 year					
Pump Test Data: Well water was ft. after hours pumping gpm					
Est. Yield gpm: Well water was ft. after hours pumping gpm					
4 TYPE OF BLANK CASING USED:					
1 Steel 3 RMP (SR)		5 Wrought iron		8 Concrete tile	
2 PVC 4 ABS		6 Asbestos-Cement		9 Other (specify below)	
		7 Fiberglass		SDR 26	
Blank casing dia: 5 in. to 30 ft. Dia		in. to ft. Dia		in. to ft. Dia	
Casing height above land surface: 12 in., weight		lbs./ft. Wall thickness or gauge No		200	
TYPE OF SCREEN OR PERFORATION MATERIAL:					
1 Steel 3 Stainless steel		5 Fiberglass		8 RMP (SR)	
2 Brass 4 Galvanized steel		6 Concrete tile		9 ABS	
				10 Asbestos-cement	
				11 Other (specify) SDR 26	
				12 None used (open hole)	
Screen or Perforation Openings Are:					
1 Continuous slot 3 Mill slot		5 Gauzed wrapped		8 Saw cut .06 11 None (open hole)	
2 Louvered shutter 4 Key punched		6 Wire wrapped		9 Drilled holes	
		7 Torch cut		10 Other (specify)	
Screen-Perforation Dia: 5 in. to 65 ft. Dia in. to ft. Dia in. to ft. Dia in. to ft.					
Screen-Perforated Intervals: From 30 ft. to 65 ft. From ft. to ft. From ft. to ft.					
Gravel Pack Intervals: From 14 ft. to 65 ft. From ft. to ft. From ft. to ft.					
5 GROUT MATERIAL: 1 Neat cement 2 Cement grout 3 Bentonite 4 Other					
Grouted Intervals: From 40" ft. to 14 ft. From ft. to ft. From ft. to ft.					
What is the nearest source of possible contamination:					
1 Septic tank 4 Cess pool		7 Sewage lagoon		10 Fuel storage 14 Abandoned water well	
2 Sewer lines 5 Seepage pit		8 Feed yard		11 Fertilizer storage 15 Oil well/Gas well	
3 Lateral lines 6 Pit privy		9 Livestock pens		12 Insecticide storage 16 Other (specify below)	
Direction from well: South		How many feet: 250		? Water Well Disinfected? Yes X No	
Was a chemical/bacteriological sample submitted to Department? Yes No X If yes, date sample					
was submitted month day year: Pump Installed? Yes X No					
If Yes: Pump Manufacturer's name: Red Jacket Model No. 75 HP 3/4 Volts 230					
Depth of Pump Intake: 50 ft. Pumps Capacity rated at 18 gal./min.					
Type of pump: 1 Submersible 2 Turbine 3 Jet 4 Centrifugal 5 Reciprocating 6 Other					
6 CONTRACTOR'S OR LANDOWNER'S CERTIFICATION: This water well was (1) constructed, (2) reconstructed, or (3) plugged under my jurisdiction and was					
completed on 12 month 30 day 80 year					
and this record is true to the best of my knowledge and belief. Kansas Water Well Contractor's License No. 236					
This Water Well Record was completed on 1 month 29 day 81 year under the business					
name of Harp Well & Pump Serv., Inc. by (signature) M. Arnold					
7 LOCATE WELL'S LOCATION WITH AN "X" IN SECTION BOX:					
FROM TO LITHOLOGIC LOG FROM TO LITHOLOGIC LOG					
0 2 Topsoil					
2 16 Clay					
16 18 Sandstone					
18 26 Fractured Rock (sandstone)					
26 34 Limestone					
34 56 Gray Shale					
56 65 Blue Shale					
ELEVATION:					
Depth(s) Groundwater Encountered 1... 28 ft. 2... ft. 3... ft. 4... ft. (Use a second sheet if needed)					
INSTRUCTIONS: Use typewriter or ball point pen, please press firmly and PRINT clearly. Please fill in blanks, underline or circle the correct answers. Send top three copies to Kansas Department of Health and Environment, Division of Environment, Water Well Contractors, Topeka, KS 66620. Send one to WATER WELL OWNER and retain one for your records.					

PHONE  
(316) 722-1411




# HARP WELL & PUMP SERVICE, INC.

Water Well Drilling - Piling Hole Drilling - Test Drilling  
Gravel Packed Wells for  
Home - Industrial - Municipal - Irrigation  
PUMP SALES & SERVICE

215 SO. TYLER ROAD

WICHITA, KANSAS 67209

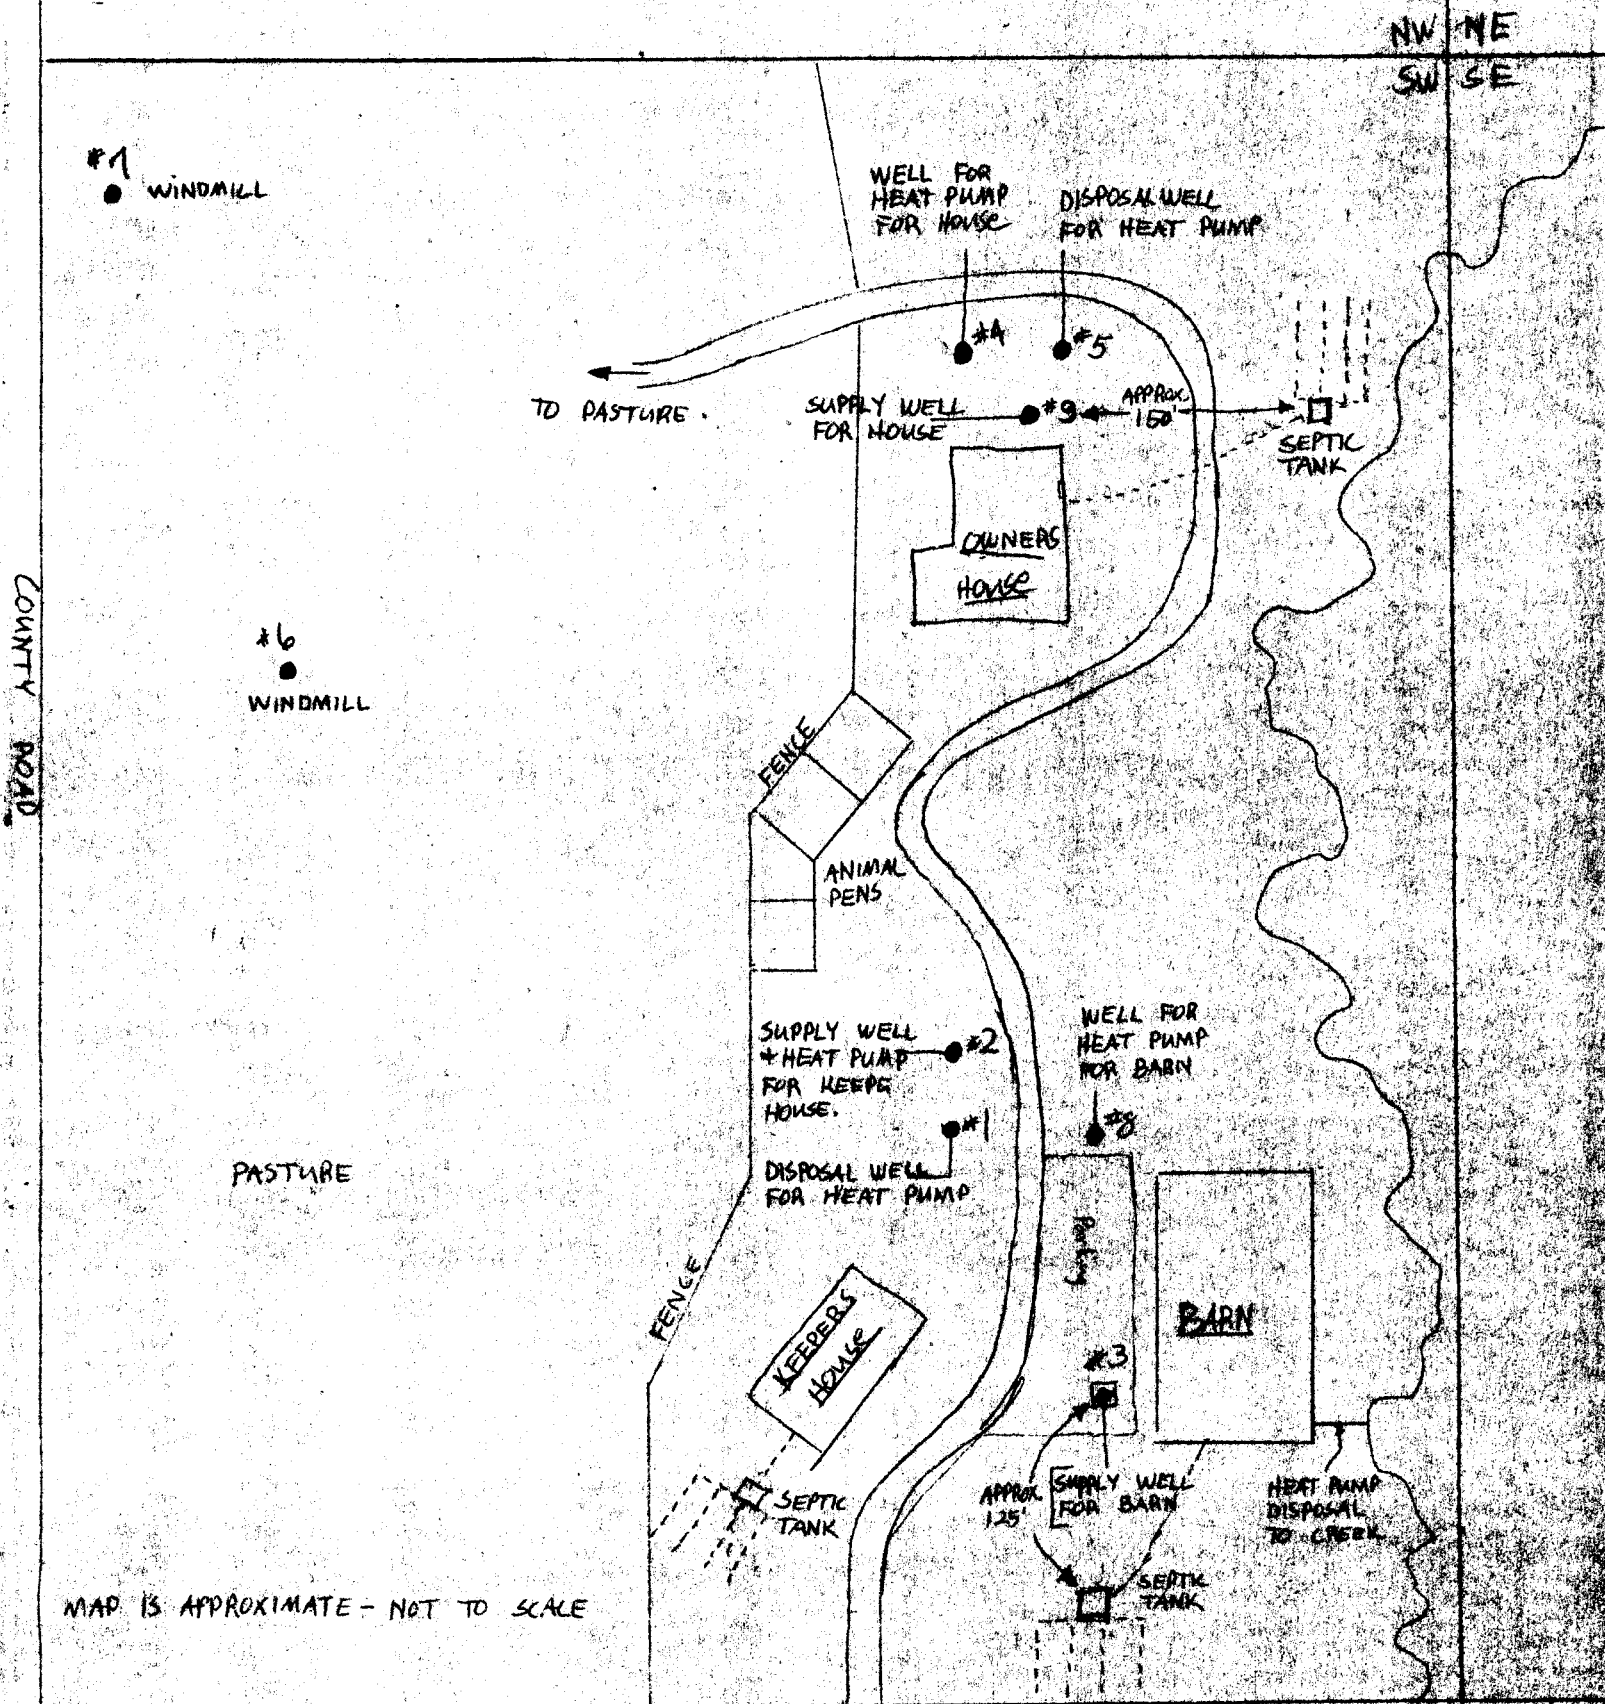

MAP IS APPROXIMATE - NOT TO SCALE