

1 LOCATION OF WATER WELL:

Fraction

County: ButlerNW_{1/4}SW_{1/4}SE_{1/4}21

Section Number

T 27

S

Range Number

R 40 E/W

Distance and direction from nearest town or city street address of well if located within city?

1 mile west of Augusta - 4 No. East side

2 WATER WELL OWNER:

RR#, St. Address, Box #:

RR #1, Box 293


City, State, ZIP Code:

Augusta, KS

Board of Agriculture, Division of Water Resources

Application Number:

3 LOCATE WELL'S LOCATION WITH AN "X" IN SECTION BOX:

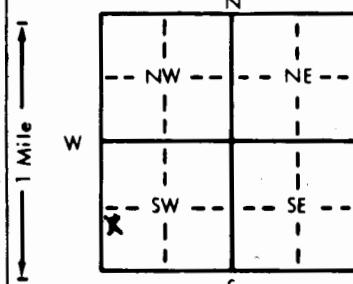

4 DEPTH OF COMPLETED WELL:

Depth(s) Groundwater Encountered 85 ft. ELEVATION: 74 ft.WELL'S STATIC WATER LEVEL 32 ft. below land surface measured on mo/day/yr 11/16/89

Pump test data: Well water was ft. after hours pumping gpm

Est. Yield 30 gpm: Well water was ft. after hours pumping gpmBore Hole Diameter 10 in. to ft., and in. to ft.

WELL WATER TO BE USED AS: 5 Public water supply 8 Air conditioning 11 Injection well

1 Domestic 3 Feedlot 6 Oil field water supply 9 Dewatering 12 Other (Specify below)

2 Irrigation 4 Industrial 7 Lawn and garden only 10 Monitoring well

Was a chemical/bacteriological sample submitted to Department? Yes No If yes, mo/day/yr sample was submitted

Water Well Disinfected? Yes No

5 TYPE OF BLANK CASING USED:

1 Steel 3 RMP (SR)
 2 PVC 4 ABS

CASING JOINTS: Glued Clamped

Welded
 Threaded

Blank casing diameter 5 in. to ft., Dia in. to ft., Dia in. to ft.Casing height above land surface +12 in., weight 160 lbs./ft. Wall thickness or gauge No.

TYPE OF SCREEN OR PERFORATION MATERIAL:

1 Steel 3 Stainless steel 5 Fiberglass 8 RMP (SR)
 2 Brass 4 Galvanized steel 6 Concrete tile 9 ABS

7 PVC 10 Asbestos-cement

11 Other (specify)
 12 None used (open hole)

SCREEN OR PERFORATION OPENINGS ARE:

1 Continuous slot 3 Mill slot
 2 Louvered shutter 4 Key punched

5 Gauzed wrapped 8 Saw cut 11 None (open hole)

6 Wire wrapped 9 Drilled holes 12 Other (specify) 7 Torch cut 10 Other (specify) SCREEN-PERFORATED INTERVALS: From 65 ft. to 85 ft., From ft. to ft.

From ft. to ft., From ft. to ft.

GRAVEL PACK INTERVALS: From 20 ft. to 85 ft., From ft. to ft.

From ft. to ft., From ft. to ft.

6 GROUT MATERIAL: 1 Neat cement 2 Cement grout 3 Bentonite 4 Other

Grout Intervals: From 5 ft. to 20 ft., From ft. to ft., From ft. to ft.

What is the nearest source of possible contamination:

1 Septic tank 4 Lateral lines 7 Pit privy 10 Livestock pens 14 Abandoned water well
 2 Sewer lines 5 Cess pool 8 Sewage lagoon 11 Fuel storage 15 Oil well/Gas well
 3 Watertight sewer lines 6 Seepage pit 9 Feedyard 12 Fertilizer storage 16 Other (specify below)

Direction from well? DOWN SLOPE SouthHow many feet? 61+

FROM TO LITHOLOGIC LOG FROM TO PLUGGING INTERVALS

0 5 Earth
5 20 Brown Clay
20 40 Yellow Clay
40 85 Grey Lime

RECEIVED
 AUG 31 1990

DIVISION OF
 ENVIRONMENT

7 CONTRACTOR'S OR LANDOWNER'S CERTIFICATION: This water well was (1) constructed, (2) reconstructed, or (3) plugged under my jurisdiction and was completed on (mo/day/year) 11/16/89 and this record is true to the best of my knowledge and belief. KansasWater Well Contractor's License No. 1193 This Water Well Record was completed on (mo/day/yr) 11/16/89 under the business name of Reeveser Well Drilling by (signature) Jerry Reeves

INSTRUCTIONS: Use typewriter or ball point pen. PLEASE PRESS FIRMLY and PRINT clearly. Please fill in blanks, underline or circle the correct answers. Send top three copies to Kansas Department of Health and Environment, Bureau of Water Protection, Topeka, Kansas 66620-7320. Telephone: 913-296-5514. Send one to WATER WELL OWNER and retain one for your records.