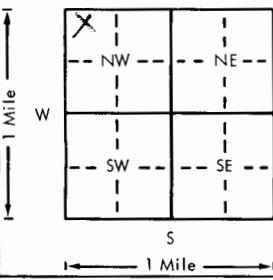
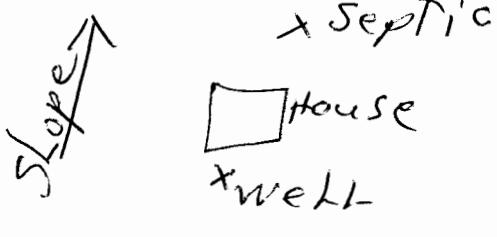


USE TYPEWRITER OR BALL
POINT PEN-PRESS FIRMLY,
PRINT CLEARLY.

WATER WELL RECORD
KSA 82a-1201-1215

Kansas Department of Health and
Environment-Division of Environment
(Water well Contractors)
Topeka, Kansas 66620

1. Location of well: <i>Bethel</i>	County <i>Bethel</i>	Fraction <i>NW 1/4 NW 1/4 NW 1/4</i>	Section number <i>22</i>	Township number <i>27</i>	Range number <i>4</i>		
2. Distance and direction from nearest town or city: <i>1 N Augusta</i>	3. Owner of well: R.R. or street: City, state, zip code: <i>Tom Carpenter R1 Augusta 67010</i>						
4. Locate with "X" in section below: 	Sketch map: 	6. Bore hole dia. <u>8</u> in. Completion date <u>8/28/78</u> Well depth <u>75</u> ft.					
5. Type and color of material	From	To	7. <input checked="" type="checkbox"/> Cable tool <input type="checkbox"/> Rotary <input type="checkbox"/> Driven <input type="checkbox"/> Dug <input type="checkbox"/> Hollow rod <input type="checkbox"/> Jetted <input type="checkbox"/> Bored <input type="checkbox"/> Reverse rotary				
<i>Top Soil</i>	0	5	8. Use: <input checked="" type="checkbox"/> Domestic <input type="checkbox"/> Public supply <input type="checkbox"/> Industry <input type="checkbox"/> Irrigation <input type="checkbox"/> Air conditioning <input type="checkbox"/> Stock <input type="checkbox"/> Lawn <input type="checkbox"/> Oil field water <input type="checkbox"/> Other				
<i>Rock</i>	5	10	9. Casing: Material <input checked="" type="checkbox"/> PS <input type="checkbox"/> Threaded <input type="checkbox"/> Welded <input checked="" type="checkbox"/> PVC <input type="checkbox"/> RMP Height: Above or below <u>18</u> in. Weight <u>100</u> lbs./ft.				
<i>Shale</i>	10	20	Dia. <u>6</u> in. to <u>25</u> ft. depth Wall thickness: inches or Dia. <u>6</u> in. to <u>ft.</u> depth Gage No. <u>195</u>				
<i>Lime</i>	20	35	10. Screen: Manufacturer's name <i>Scot Flower</i>				
<i>Shale</i>	35	50	Type <u>100</u> Dia. <u>6</u> Slot/gauze <u>1/16</u> Length <u>20</u> Set between <u>55</u> ft. and <u>75</u> ft. ft. and ft. Gravel pack? <input checked="" type="checkbox"/> Yes Size range of material <u>3/8</u>				
<i>Sandy Lime</i>	50	75	11. Static water level: <u>55</u> ft. below land surface Date _____				
			12. Pumping level below land surfaces: <u>55</u> ft. after <u>1</u> hrs. pumping _____ g.p.m. ft. after _____ hrs. pumping _____ g.p.m. Estimated maximum yield _____ g.p.m.				
			13. Water sample submitted: Yes <input checked="" type="checkbox"/> No <input type="checkbox"/> Date _____				
			14. Well head completion: <input type="checkbox"/> Pitless adapter _____ Inches above grade				
			15. Well grouted? <input checked="" type="checkbox"/> Yes With: <input checked="" type="checkbox"/> Neat cement <input type="checkbox"/> Bentonite <input type="checkbox"/> Concrete Depth: From <u>0</u> ft. to <u>10</u> ft.				
			16. Nearest source of possible contamination: ft. <u>150</u> Direction <u>NNE</u> Type <u>Septic</u> Well disinfected upon completion? <input checked="" type="checkbox"/> Yes <input type="checkbox"/> No				
			17. Pump: <input checked="" type="checkbox"/> Not installed Manufacturer's name _____ Model number _____ HP _____ Volts _____ Length of drop pipe _____ ft. capacity _____ g.p.m. Type: <input type="checkbox"/> Submersible <input type="checkbox"/> Turbine <input type="checkbox"/> Jet <input type="checkbox"/> Reciprocating <input type="checkbox"/> Centrifugal <input type="checkbox"/> Other				
(Use a second sheet if needed)			18. Elevation: Topography: <input checked="" type="checkbox"/> Hill <input checked="" type="checkbox"/> Slope <input type="checkbox"/> Upland <input type="checkbox"/> Valley	19. Remarks: <i>Owner to install cement slab around well head</i>	20. Water well contractor's certification: This well was drilled under my jurisdiction and this report is true to the best of my knowledge and belief. Business name <i>Winter Well Drill 251</i> Address <i>R2 Box 30 Augusta</i> Signed <i>Tom Carpenter</i> Date <i>8/11/78</i> Authorized representative _____		