

1 LOCATION OF WATER WELL:

Fraction

SE $\frac{1}{4}$

Section Number

Township Number

Range Number

County: Butler

22

T 27 S

R 4

E/W

Distance and direction from nearest town or city street address of well if located within city?

Reed MITSCH Augusta

2 WATER WELL OWNER:

Reed MITSCH ADDRESS??!

RR#, St. Address, Box #:


17 Angelina

Board of Agriculture, Division of Water Resources

City, State, ZIP Code

Application Number: X

3 LOCATE WELL'S LOCATION WITH AN "X" IN SECTION BOX:

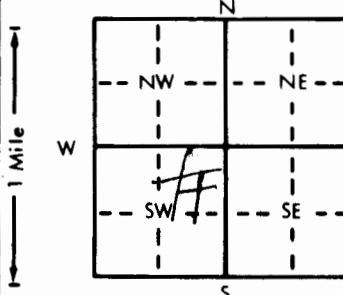

4 DEPTH OF COMPLETED WELL... 150 ft. ELEVATION:

Depth(s) Groundwater Encountered 1. 75 ft. 2. ft. 3. ft.

WELL'S STATIC WATER LEVEL 20 ft. below land surface measured on mo/day/yr

Pump test data: Well water was ft. after hours pumping gpm

Est. Yield 8 gpm. Well water was ft. after hours pumping gpm

Bore Hole Diameter 8.5 in. to ft., and in. to ft.

WELL WATER TO BE USED AS: 5 Public water supply 8 Air conditioning 11 Injection well

1 Domestic 3 Feedlot 6 Oil field water supply 9 Dewatering 12 Other (Specify below)

2 Irrigation 4 Industrial 7 Lawn and garden only 10 Observation well

Was a chemical/bacteriological sample submitted to Department? Yes No. If yes, mo/day/yr sample was submitted

Water Well Disinfected? Yes No

5 TYPE OF BLANK CASING USED:

1 Steel 3 RMP (SR)
2 PVC 4 ABS

5 Wrought iron 8 Concrete tile Casing joints: Glued X Clamped

6 Asbestos-Cement 9 Other (specify below) Welded

7 Fiberglass Threaded

Blank casing diameter 5 in. to 150 ft., Dia. in. to ft., Dia. in. to ft.

Casing height above land surface 18 in., weight 200 lbs./ft. Wall thickness or gauge No. 24

TYPE OF SCREEN OR PERFORATION MATERIAL:

1 Steel 3 Stainless steel 5 Fiberglass 7 PVC 10 Asbestos-cement
2 Brass 4 Galvanized steel 6 Concrete tile 8 RMP (SR) 11 Other (specify)
9 ABS

SCREEN OR PERFORATION OPENINGS ARE:

1 Continuous slot 3 Mill slot 5 Gauzed wrapped 8 Saw cut 11 None (open hole)
2 Louvered shutter 4 Key punched 6 Wire wrapped 9 Drilled holes
7 Torch cut 10 Other (specify)

SCREEN-PERFORATED INTERVALS: From 40 ft. to 60 ft., From 120 ft. to 130 ft.

GRAVEL PACK INTERVALS: From ft. to ft., From ft. to ft., From ft. to ft.

From ft. to ft., From ft. to ft., From ft. to ft.

6 GROUT MATERIAL: 1 Neat cement 2 Cement grout 3 Bentonite 4 Other

Grout Intervals: From 3 ft. to 13 ft., From ft. to ft., From ft. to ft.

What is the nearest source of possible contamination:

1 Septic tank 4 Lateral lines 7 Pit privy 10 Livestock pens 14 Abandoned water well
2 Sewer lines 5 Cess pool 8 Sewage lagoon 11 Fuel storage 15 Oil well/Gas well
3 Watertight sewer lines 6 Seepage pit 9 Feedyard 12 Fertilizer storage 16 Other (specify below)

Direction from well? W

FROM TO LITHOLOGIC LOG FROM TO LITHOLOGIC LOG

0	3	Soil			
3	10	Clay			
10	20	Pack			
20	35	Shale			
35	75	Lime			
75	150	Shale			

7 CONTRACTOR'S OR LANDOWNER'S CERTIFICATION: This water well was (1) constructed, (2) reconstructed, or (3) plugged under my jurisdiction and was completed on (mo/day/year) 6/18/81 and this record is true to the best of my knowledge and belief. Kansas

Water Well Contractor's License No. 257 This Water Well Record was completed on (mo/day/year) 6/23/81 under the business name of Winter Well Drill by (signature) Charles Winter

INSTRUCTIONS: Use typewriter or ball point pen, PLEASE PRESS FIRMLY and PRINT clearly. Please fill in blanks, underline or circle the correct answers. Send top three copies to Kansas Department of Health and Environment, Division of Environment, Environmental Geology Section, Topeka, KS 66620. Send one to WATER WELL OWNER and retain one for your records.