

## WATER WELL RECORD Form WWC-5 KSA 82a-1212

1 LOCATION OF WATER WELL:

County: Batther

Fraction

NE 1/4 NE 1/4 NW 1/4

Section Number

22

Township Number

T 27 S

Range Number

R 4 E

Distance and direction from nearest town or city street address of well if located within city?

In City of AugustaLeland Marley 1517 Ohio

2 WATER WELL OWNER:

RR#, St. Address, Box #

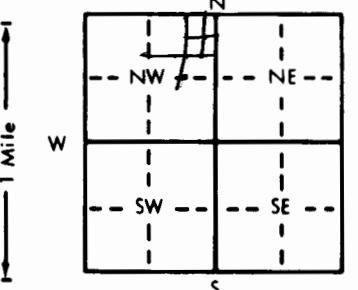
City, State, ZIP Code

Augusta Kan

Board of Agriculture, Division of Water Resources

Application Number:

3 LOCATE WELL'S LOCATION WITH AN "X" IN SECTION BOX:

4 DEPTH OF COMPLETED WELL: 105 ft. ELEVATION:Depth(s) Groundwater Encountered 1.85 ft. 2. ft. 3. ft.WELL'S STATIC WATER LEVEL 35 ft. below land surface measured on mo/day/yr

Pump test data: Well water was ft. after hours pumping gpm

Est. Yield 40 gpm; Well water was ft. after hours pumping gpmBore Hole Diameter 8.5 in. to ft. and in. to ft.

WELL WATER TO BE USED AS: 5 Public water supply 8 Air conditioning 11 Injection well

1 Domestic 3 Feedlot 6 Oil field water supply 9 Dewatering 12 Other (Specify below)

2 Irrigation 4 Industrial 7 Lawn and garden only 10 Monitoring wellWas a chemical/bacteriological sample submitted to Department? Yes  No  If yes, mo/day/yr sample was submittedWater Well Disinfected? Yes  No 

5 TYPE OF BLANK CASING USED:

1 Steel  3 RMP (SR)2 PVC  4 ABS

5 Wrought iron

6 Asbestos-Cement

7 Fiberglass

8 Concrete tile

9 Other (specify below)

CASING JOINTS: Glued  Clamped Welded Threaded Blank casing diameter 5 in. to 70 ft. Dia. in. to ft. Dia. in. to ft.Casing height above land surface 18 in., weight 200 lbs./ft. Wall thickness or gauge No. 12.14

TYPE OF SCREEN OR PERFORATION MATERIAL:

1 Steel  3 Stainless steel 2 Brass  4 Galvanized steel 

5 Fiberglass

6 Concrete tile

7 PVC

8 RMP (SR)

9 ABS

10 Asbestos-cement

11 Other (specify) 12 None used (open hole) 

SCREEN OR PERFORATION OPENINGS ARE:

1 Continuous slot  3 Mill slot 2 Louvered shutter  4 Key punched 

5 Gauzed wrapped

6 Wire wrapped

7 Torch cut

8 Saw cut

9 Drilled holes

10 Other (specify) 11 None (open hole) SCREEN-PERFORATED INTERVALS: From 70 ft. to 105 ft. From ft. to ft. From ft. to ft.

From ft. to ft. From ft. to ft. From ft. to ft. From ft. to ft.

GRAVEL PACK INTERVALS: From ft. to ft. From ft. to ft. From ft. to ft. From ft. to ft.

From ft. to ft. From ft. to ft. From ft. to ft. From ft. to ft.

6 GROUT MATERIAL: 1 Neat cement  2 Cement grout  3 Bentonite  4 Other Grout Intervals: From 0 ft. to 28 ft. From ft. to ft. From ft. to ft. From ft. to ft.

What is the nearest source of possible contamination:

1 Septic tank  4 Lateral lines 2 Sewer lines  5 Cess pool 3 Watertight sewer lines  6 Seepage pit 

7 Pit privy

8 Sewage lagoon

9 Feedyard

10 Livestock pens

11 Fuel storage

12 Fertilizer storage

13 Insecticide storage

14 Abandoned water well

15 Oil well/Gas well

16 Other (specify below) Direction from well? SHow many feet? 150

FROM TO LITHOLOGIC LOG FROM TO PLUGGING INTERVALS

0 5 SOIL5 22 Chay + Shale22 105 Shale + Lime7 CONTRACTOR'S OR LANDOWNER'S CERTIFICATION: This water well was  constructed, (2) reconstructed, or (3) plugged under my jurisdiction and was completed on (mo/day/year) 11/21/89 and this record is true to the best of my knowledge and belief. KansasWater Well Contractor's License No. 251 This Water Well Record was completed on (mo/day/yr) 2/3/89 by (signature) Charles Winterunder the business name of Winter Well Drilling by (signature) Charles Winter

INSTRUCTIONS: Use typewriter or ball point pen. PLEASE PRESS FIRMLY and PRINT clearly. Please fill in blanks, underline or circle the correct answers. Send top three copies to Kansas Department of Health and Environment, Bureau of Water Protection, Topeka, Kansas 66620-7320. Telephone: 913-296-5514. Send one to WATER WELL OWNER and retain one for your records.