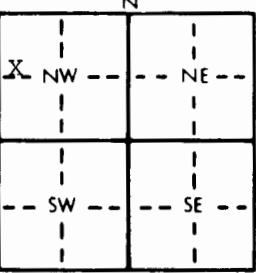
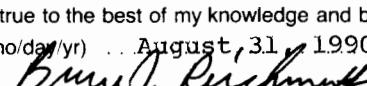



1 LOCATION OF WATER WELL:		Fraction SW 1/4 NW 1/4 NW 1/4	Section Number 22	Township Number T 27 S	Range Number R 4 EW
Distance and direction from nearest town or city street address of well if located within city? Approximately 300' west of 1315 Money St. In Augusta.					
2 WATER WELL OWNER: KANE Pipeline Company RR#, St. Address, Box # : 100 North Broadway, Suite 550 City, State, ZIP Code : Wichita, Ks. 67202			Board of Agriculture, Division of Water Resources Application Number:		
3 LOCATE WELL'S LOCATION WITH AN "X" IN SECTION BOX: 		4 DEPTH OF COMPLETED WELL..... 16 ft. ELEVATION: Depth(s) Groundwater Encountered 1 ft. 2 ft. 3 ft. WELL'S STATIC WATER LEVEL 11 1/2 ft. below land surface measured on mo/day/yr 7/31/90 Pump test data: Well water was ft. after hours pumping gpm Est. Yield gpm: Well water was ft. after hours pumping gpm Bore Hole Diameter in. to ft., and in. to ft. WELL WATER TO BE USED AS: 5 Public water supply 8 Air conditioning 11 Injection well 1 Domestic 3 Feedlot 6 Oil field water supply 9 Dewatering 12 Other (Specify below) 2 Irrigation 4 Industrial 7 Lawn and garden only 10 Monitoring well Was a chemical/bacteriological sample submitted to Department? Yes No X If yes, mo/day/yr sample was submitted Water Well Disinfected? Yes No X			
5 TYPE OF BLANK CASING USED: 1 Steel 3 RMP (SR) 2 PVC 4 ABS		5 Wrought iron 6 Asbestos-Cement 7 Fiberglass	8 Concrete tile 9 Other (specify below)	CASING JOINTS: Glued Clamped Welded Threaded X	
Blank casing diameter 4 in. to 16 ft., Dia in. to ft., Dia in. to ft.					
Casing height above land surface 24 in., weight 2.411 lbs./ft. Wall thickness or gauge No. 248" W					
TYPE OF SCREEN OR PERFORATION MATERIAL: 1 Steel 3 Stainless steel 2 Brass 4 Galvanized steel 5 Fiberglass 6 Concrete tile 7 PVC 8 RMP (SR) 9 ABS 10 Asbestos-cement 11 Other (specify) 12 None used (open hole)					
SCREEN OR PERFORATION OPENINGS ARE: 1 Continuous slot 3 Mill slot 2 Louvered shutter 4 Key punched 5 Gauzed wrapped 6 Wire wrapped 7 Torch cut 8 Saw cut 9 Drilled holes 10 Other (specify) 11 None (open hole)					
SCREEN-PERFORATED INTERVALS: From 8 ft. to 16 ft., From ft. to ft. From ft. to ft., From ft. to ft.					
GRAVEL PACK INTERVALS: From 6 ft. to 16 ft., From ft. to ft. From ft. to ft., From ft. to ft.					
6 GROUT MATERIAL: 1 Neat cement 2 Cement grout 3 Bentonite 4 Other Grout Intervals: From 0 ft. to 3 ft., From 3 ft. to 6 ft., From ft. to ft. What is the nearest source of possible contamination: 1 Septic tank 4 Lateral lines 7 Pit privy 10 Livestock pens 14 Abandoned water well 2 Sewer lines 5 Cess pool 8 Sewage lagoon 11 Fuel storage 15 Oil well/Gas well 3 Watertight sewer lines 6 Seepage pit 9 Feedyard 12 Fertilizer storage 16 Other (specify below) 13 Insecticide storage 14 Petroleum Product					
Direction from well? West How many feet? 30' Pipeline					
FROM	TO	LITHOLOGIC LOG	FROM	TO	PLUGGING INTERVALS
0	4	Top soil			
4	8	Brown clay			
8	13	Dark Brown clay			
13	16	Fine to medium sand			
16		Rock			
7 CONTRACTOR'S OR LANDOWNER'S CERTIFICATION: This water well was (1) constructed, (2) reconstructed, or (3) plugged under my jurisdiction and was completed on (mo/day/year) 7/31/90 and this record is true to the best of my knowledge and belief. Kansas Water Well Contractor's License No. 145 This Water Well Record was completed on (mo/day/yr) August 31, 1990 under the business name of Henkle Drilling & Supply Co., Inc. by (signature) 					
INSTRUCTIONS: Use typewriter or ball point pen. PLEASE PRESS FIRMLY and PRINT clearly. Please fill in blanks, underline or circle the correct answers. Send top three copies to Kansas Department of Health and Environment, Bureau of Water, Topeka, Kansas 66620-7320. Telephone: 913-296-5545. Send one to WATER WELL OWNER and retain one for your records.					

CONTRACTOR'S OR LANDOWNER'S CERTIFICATION: This water well was (1) constructed, (2) reconstructed, or (3) plugged under my jurisdiction and was completed on (mo/day/year) 7/31/90 and this record is true to the best of my knowledge and belief. Kansas

Water Well Contractor's License No. 145..... This Water Well Record was completed on (mo/day/yr) ... August, 31, 1990.....
under the business name of Henkle Drilling & Supply Co., Inc. by (signature) *Bruce Henkle*

INSTRUCTIONS: Use typewriter or ball point pen. **PLEASE PRESS FIRMLY** and **PRINT** clearly. Please fill in blanks, underline or circle the correct answers. Send top three copies to Kansas Department of Health and Environment, Bureau of Water, Topeka, Kansas 66620-2220, Telephone: 913-296-5545. Send one to WATER WELL OWNER and retain one for your records.

INSTRUCTIONS: Use typewriter or ball point pen. PLEASE PRESS FIRMLY and PRINT clearly. Please fill in blanks, underline or circle the correct answers. Send top three copies to Kansas Department of Health and Environment, Bureau of Water, Topeka, Kansas 66620-7320. Telephone: 913-296-5545. Send one to WATER WELL OWNER and retain one for your records.

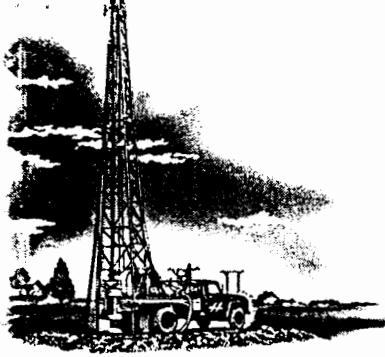

— Henkle

DRILLING & SUPPLY CO., INC.

3795 W. JONES AVE.
316/277-2389
FAX/277-0224

P.O. Box 639
GARDEN CITY, KANSAS 67846

CUSTOMER'S NAME Superior Environmental DATE July 31, 1990
STREET ADDRESS P. O. Box 893 TEST # E. LOG Augered
CITY & STATE Norman, Oklahoma 73079 DRILLER
COUNTY QUARTER SECTION TOWNSHIP RANGE
LOCATION MW - 2 Augusta Ks.